

Name Samuel Gazan
 Address 112 Bertwell Road

#5029
 Service No.

Location 112 Bertwell Road

Kind of Pipe		Size	Size of Main	Location	
Repairs & Renewal - New Service		Com. 9-19-49		Location	
Date	Material	Amount	Total	Date	Amount
July 16, '49	Labor	5 57	5 57	July 16, '49	35 00
	10% Overhead		56	Sept 21, '49	7 87
	29' - 3/4" Copper Tubing @.24	6 96	6 96	Refunded Non-Charge	
	1 - 3/4" C x 1/2" I.W.H. S&W	3 29	3 29	July 16, '49	5 58
	Trucking 1 hr.		75	37' - 3/4" Copper Tubing @.24	8 88
	Littlefield Shovel 1 hr.	7 00	7 00	1 - 3/4" C Corp-cock	3 15
	Allis Chalmers 1 hr.	3 00	3 00	1 - 3/4" C x 3/4" C Curb-cock	3 85
			27 13	1 - Box & Rod	3 95
				1 - 1/2" Offset Tail Piece	37
				1 - 1/2" Straight Tail Piece	37
				Littlefield Shovel 1 hr.	7 00
				Allis Chalmers 1 hr.	3 00
	Labor			Trucking 1 hr.	75
					36 90

TOWN OF LEXINGTON - BOARD OF PUBLIC WORKS
WATER DIVISION

The undersigned applies for a supply of water at No..... St. and hereby agrees to comply with the rules and regulations as now, or at any future time, established by the Board of Selectmen.

Am't of Estimate \$.....


Owner

Am't Paid \$.....

Address

Builder

Sketch of Service Here

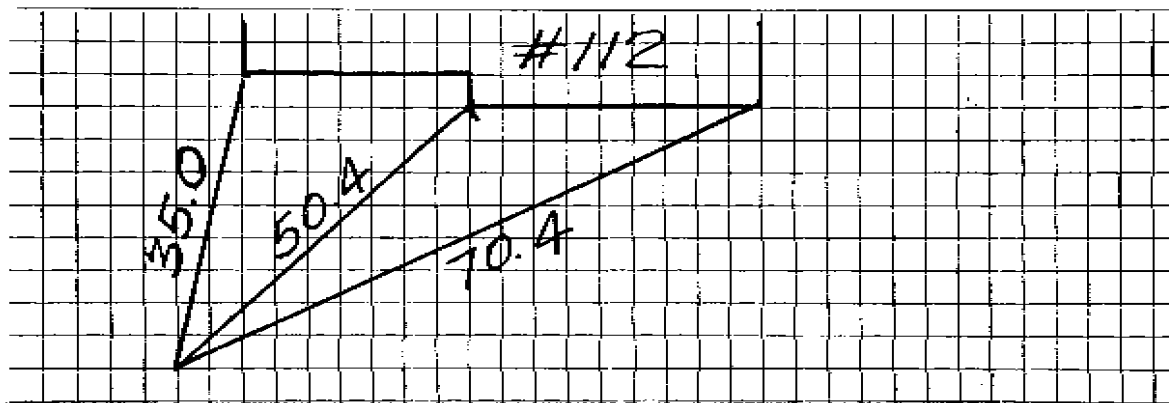

Connection made in Street.

Work completed19

Remarks: