

Name Walter & Annie MacFawn
 Address 42 Percy Road, Lexington
 12 Bertwell Rd.

Service No. 61 248
 # 5526

Location Lots 4 - 5, Bertwell Road

Kind of Pipe Size Size of Main

~~Repairs-Renewals~~ - New Service

Location

Date	Material	Amount	Total	Date	Amount
Com. 76.00	37 1" C.L. Pipe @.27	9 99			
9-15-31	2 1" L.L. Coup. @.25	50			
	1 1" L.L. Ell	30			
	1 1" Br. Sp. Nipple	25			
	1 S & W	3 00			
	Trucking	75	14 79		
9/9/31	7 Hrs. Labor @.55	3 85			
	3 " " @.60	1 80	5 65		
	15% Overhead		85		
			21 29		
	Labor				
Charge	34 2/3 ft. @.75	\$26 00	\$26 00		

Sept 3 1931 Cash 26

Lexington
 Hadley Press, Inc.

COST

DATE September 5, 1931

TOWN OF LEXINGTON—BOARD OF PUBLIC WORKS

WATER DIVISION

The undersigned applies for a supply of water at No. 425 Bertwell St. and hereby agrees to comply with the rules and regulations as now, or at any future time, established by the Board of Selectmen.

Am't. of Estimate \$ _____

Owner


Walter & Annie Mae Fawn

Am't. Paid \$ _____

Address

42 Percy Road
Lexington Mass

Builder _____

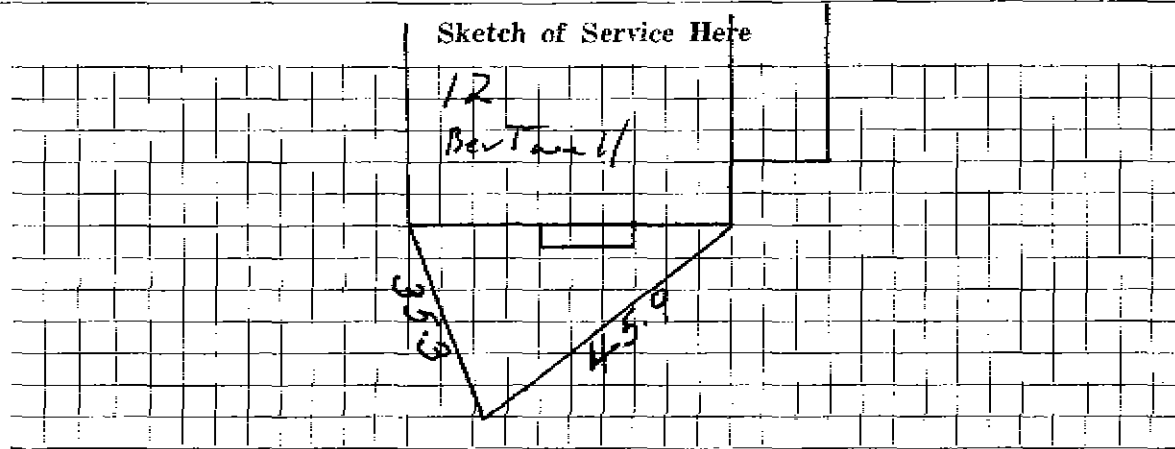

Connection made in _____ Street.

Work completed _____ 19

Remarks: