

## WATER SERVICE RECORD

Name Louis Stoico

Service No. 126

Address 17 Bertwell Road

2913

Location

~~Repair/Replace~~ - New Service

Comm. 9-3-57


Date	Material	Amount	Total	Date	Amount
7/11/57	Labor	1 76		6-27-57	Deposit \$ 50 00
	10% overhead	18	1 94	9-3-57	Refund \$ 10 48
	70' - 3/4" Copper tubing @ .4228	29 60			NON CHARGE \$ 39 52
	1 - 3/4" Cx 1/2 I.W.H. Stop & Waste	4 96	7/11/57	Labor	1 76
	1 - 3/4" Union (3 part)	2 27		10' - 3/4" Copper tubing @ .4228	4 23
	1 hr. Trucking		75	1 - 3/4" C. Corp Cock	4 64
			39 52	1 - 3/4" C. Curb Cock	5 94
				1 Box & Rods	4 62
9-17-52	2 3/4 Comp Unions			1 - 1/2 Straight tailpiece	50
	5' 3/4 Copper			1 - 1/2 Offset tailpiece	50
					22 19

DATE \_\_\_\_\_

TOWN OF LEXINGTON — BOARD OF PUBLIC WORKS

**WATER DIVISION**

Sketch of Service Here

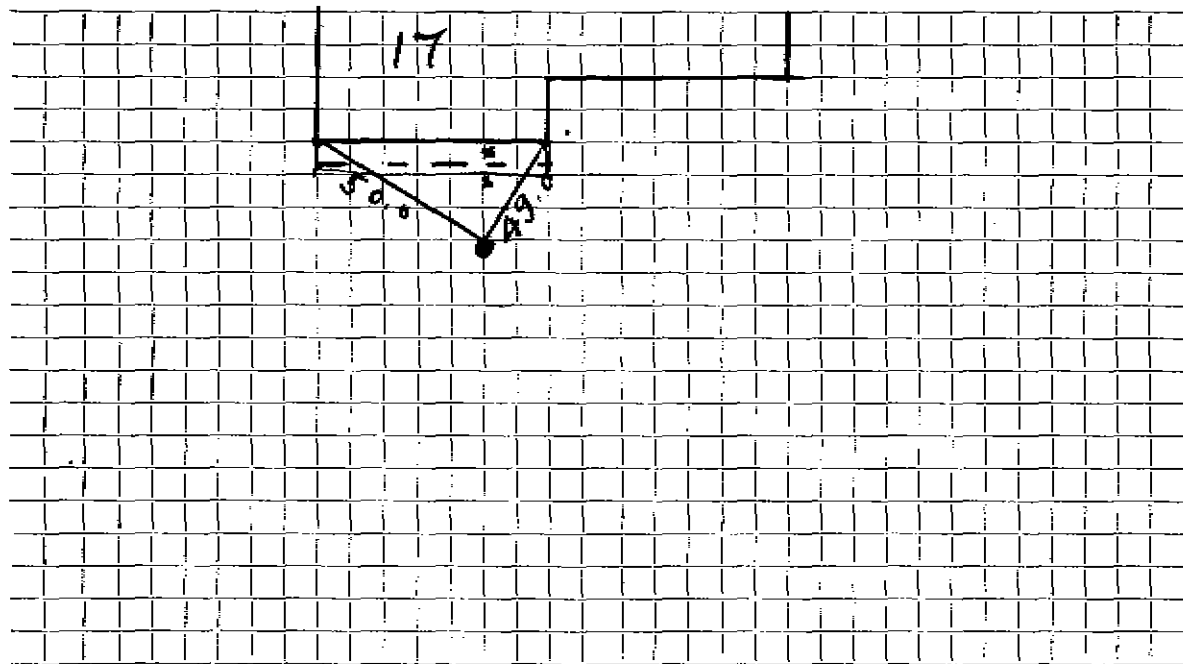

Connection made in \_\_\_\_\_ Street. Work completed \_\_\_\_\_

Remarks: **A DEEP AT UNIONS 2-1/2 UNIONS**