

Name Thomas J. Hyndman (Builder) Paul Olsen (Owner)

Service No.

#4201
~~49~~ 250
 #4200

Address 18 Bertwell Rd.

103 Lincoln Road, Medford

Location #18 Bertwell Road

Kind of Pipe

Size

Size of Main

~~Repair~~ ~~Renewal~~ New Service

Location

Date 1936	Material	Amount	Total	Date	Location	Amount
Nov. 10	2 hrs. @ 30¢	1 20		Nov. 7 1936	Cash	37 50
Nov 10 1936	10% overhead	12	1 32	Dec 7 1936	Refunded	1 95
	40' 3/4" Cop. Pipe	3.19 7 60				35 35
	1 S. and W.	1 75				
	Trucking	75	10 10			
			<u>31 42</u>			
	Say: 40' @ 50¢	\$20 00				
	Trench Repairs	15 55				
		<u>\$35 55</u>				
	Labor					

Hadley Press, Inc., Lexington

DATE November 9, 1936

TOWN OF LEXINGTON—BOARD OF PUBLIC WORKS
WATER DIVISION

The undersigned applies for a supply of water at No. 18 Bertwell Rd and hereby agrees to comply with the rules and regulations as now, or at any future time, established by the Board of Selectmen.

Am't. of Estimate \$ 37.50

Owner Paul Olsen


Am't. Paid \$ _____

Address 103 Lincoln Rd.

Builder _____

Medford, Mass.

Sketch of Service Here

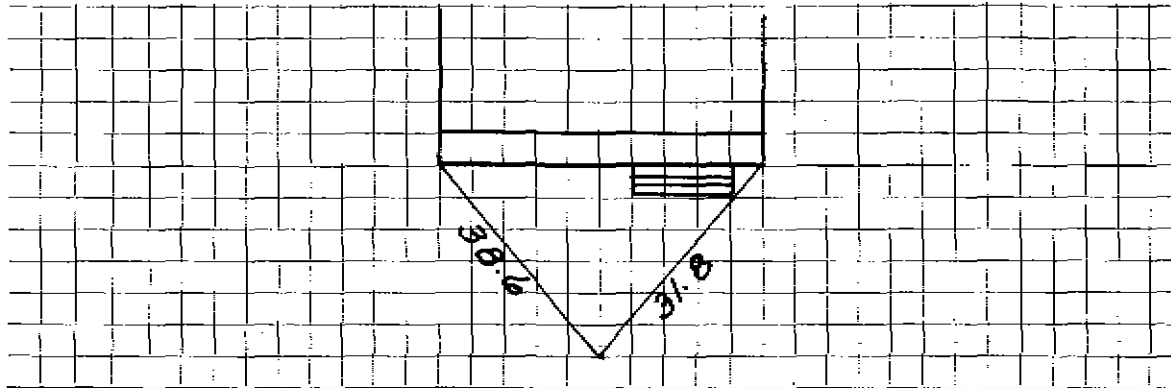

Connection made in _____ Street. Work completed _____ 19

Remarks: