

Name Brown & Estey

Service No. ⁷⁷ 253

Address

~~83 Apolsten St., Arlington~~
23 Bertwell Rd.

23 Bertwell Rd.

Location Lts 3 - 7, inc. Bertwell Rd.

Kind of Pipe

Size

Size of Main

~~Repair - Renewal~~ - New Service

Location

Date	Material	Amount	Total	Date	Amount
	60 1" C.L. Pipe @ .27	16 20			
	3 1" L.L. Coup. @ .30	90		Dec. 26 1930 - Cash	33 75
	2 1" L.L. Ell @ .35	70		Mar. 10 1931 - Cash	11 25
	1 1" Br. Sp & Nip.	25			
	1 S & W	3 00			
	Trucking	75	21 80		
1/6/31	12 Hrs. Labor @ .55	6 60			
	3 " " @ .60	1 80	8 40		
	15% Overhead		1 26		
			31 46		
	Labor				
CHARGE	60 ft. @ .75	\$45 00	\$45 00		

Hudley Press, Inc. Lexington

DATE Dec. 26, 1930

TOWN OF LEXINGTON—BOARD OF PUBLIC WORKS
WATER DIVISION

The undersigned applies for a supply of water at No. Lot 2-3, 4, 5, 6, + 7 - Birtwell Road St. and hereby agrees to comply with the rules and regulations as now, or at any future time, established by the Board of Selectmen.

Am't. of Estimate \$ _____

Owner M. F. Brown


Am't. Paid \$ _____

Address 83 - Appleton

Builder T. Brown & Co.

Lexington

Sketch of Service Here

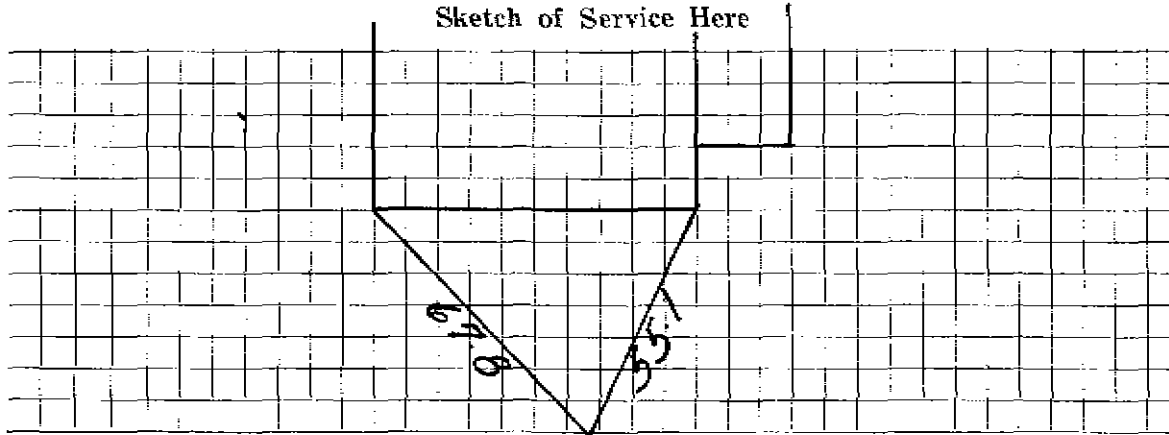

Connection made in _____ Street.

Work completed _____ 19

Remarks: