

WATER SERVICE RECORD

Name

Service No.

Address

26 Bertwell Road

Location


Repair—Renewal—New Service

Date	Material	Amount	Total	Date	Amount
					<i>OUTSIDE</i>
				8/31/85	25' 3/4" Copper
					3/4 Curb Stop
					1 3/4 Corp. Adpt
					1 1" 90° Elbow
					1 1" x 3/4 Copper El
					1 Box & Rod
					1 1" Repair Clamp
					1 1"x4" C.L. Nipple
					1 1" L.L. Coupling
				25	Yards Gravel
					1 1" Brass EL
					1 1"x3/4 Brass Bushing

TOWN OF LEXINGTON — BOARD OF PUBLIC WORKS

WATER DIVISION

Sketch of Service Here

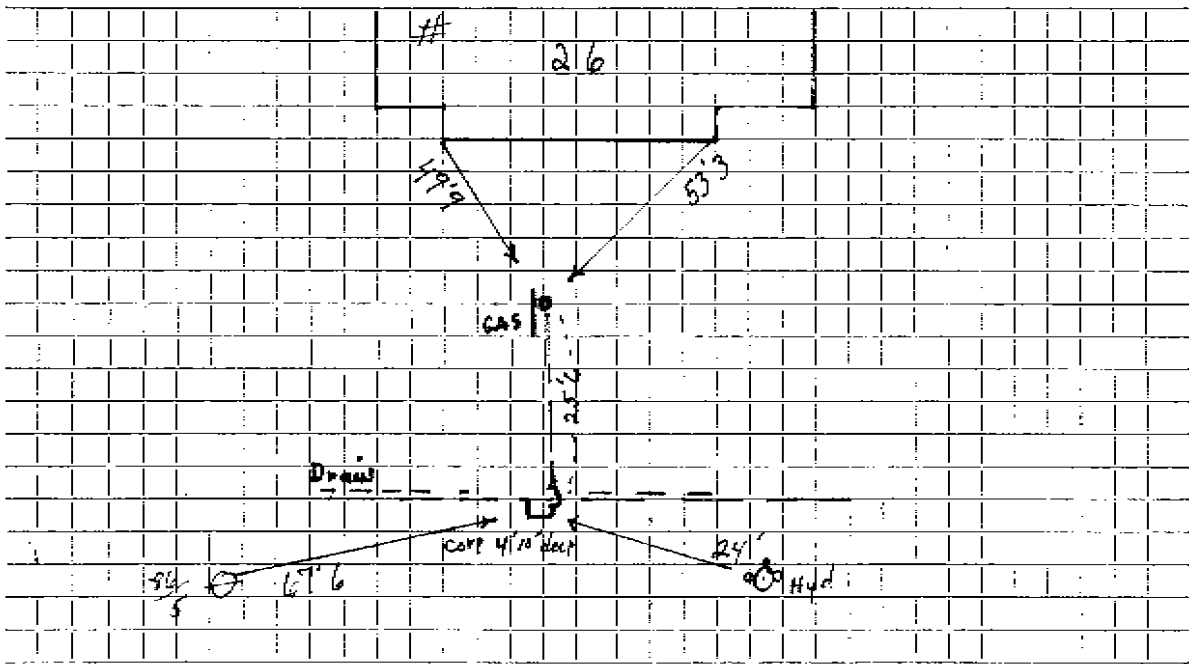

Connection made in ..... Street. Work completed .....

Remarks: *Service tap on back of main, service over water under drain.*

.....

.....