

WATER SERVICE RECORD

Name George MacAuley

Service No. 157

Address ³⁰ Bertwell Road

Location Lexington, Mass.


~~Repair~~—Renewal—New Service *Com-10-1-51*

Date	Material	Amount	Total	Date	Amount
8-7-51	Labor	1 49	1 49	7-12-51	Deposited 25 00
	10% Overhead		15	10-10-51	Paid 12 45
	90'-3/4" Copper Tubing		29 34		37 45
	1-3/4" Cx 1/2" I.W.H. S&W		4 00		No Charge
	1-3/4" Cx 3/4" C Union (3 pts)		1 72	8-7-51	Labor 1 49
	1 Hr Trucking		75		30'-3/4" Copper Tubing @.326 9 78
			37 45		1-3/4" C Corp-Cock 4 33
					1-3/4" Cx 3/4" C. Curb-Cock 4 67
					1-Box & Rod 4 68
					1-1/2 Offset Tail Piece 50
					1-1/2 Straight Tail Piece 50
					1 Hr. Trucking 75
					Patching 8x3 8 00
					34 70
					<i>6.11.51 9-24-51</i>

DATE _____

TOWN OF LEXINGTON — BOARD OF PUBLIC WORKS
WATER DIVISION

Sketch of Service Here

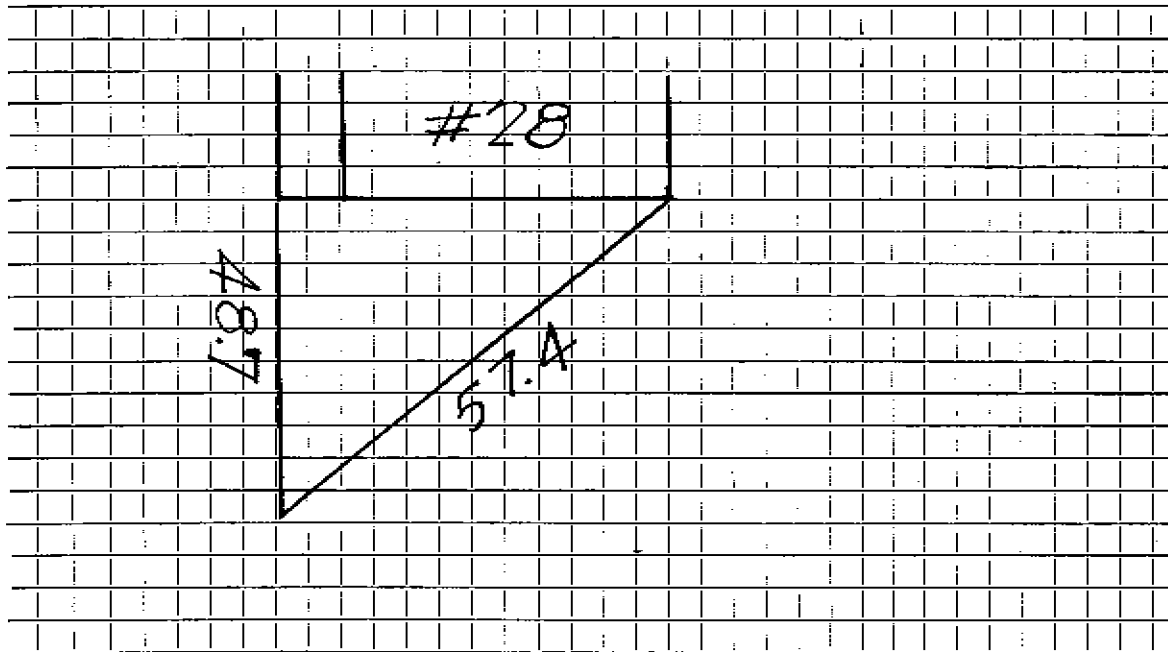

Connection made in _____ Street. Work completed _____

Remarks: _____
