

DATE 11/28

TOWN OF LEXINGTON - BOARD OF PUBLIC WORKS

WATER DIVISION

The undersigned applies for a supply of water at No..... St. and hereby agrees to comply with the rules and regulations as now, or at any future time, established by the Board of Selectmen.

Am't of Estimate \$.....

Owner


Am't Paid \$.....

Address

Builder

to
Crocker
ton

Sketch of Service Here

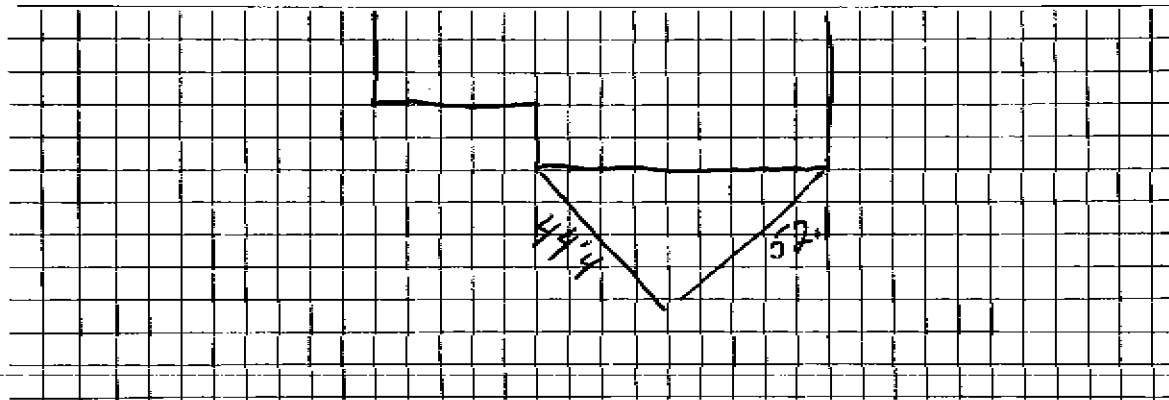

Connection made in Street.

Work completed19

Remarks:

1059
Service No. ± 257

Name Fred L. Green

Address ~~50 Elm St., W. Newton~~
31 Bertwell Rd.

Location 31 Bertwell Road

Kind of Pipe

Size

Size of Main

~~Repair - Renewal~~ - New Service

Location

Date	Material	Amount	Total	Date	Amount
<i>Comm. 3-28-33 for 28.20</i>	50' $\frac{1}{2}$ " Copper Pipe @.12	\$6 00		<i>Jan. 5 1933 - Cash</i>	<i>28 20</i>
	1 S & W Trucking	3 00 <u>75</u>	9 75		
	7 Hrs. Labor @.55	3 85			
	2 " " @.60	<u>1 20</u>			
	15% Overhead	<u>76</u>	5 81		
	<u>Cost</u>		15 56		
	50' @ .60	\$30.00, but the deposit was \$28.20, so say	<u>\$28 20</u>		
	Labor				

Hadley Press, Inc., Lexington

Handwritten initials and numbers

DATE 1/4/33

TOWN OF LEXINGTON—BOARD OF PUBLIC WORKS
Lot 70 & 71 WATER DIVISION

The undersigned applies for a supply of water at No. 31 Bartwell St. and hereby agrees to comply with the rules and regulations as now, or at any future time, established by the Board of Selectmen.

Am't. of Estimate \$ 28.39


Owner Fred L Green, P. H. Crocker

Am't. Paid \$ 28.39

Address 50 Elm St. West Newton

Builder Wadley

Sketch of Service Here

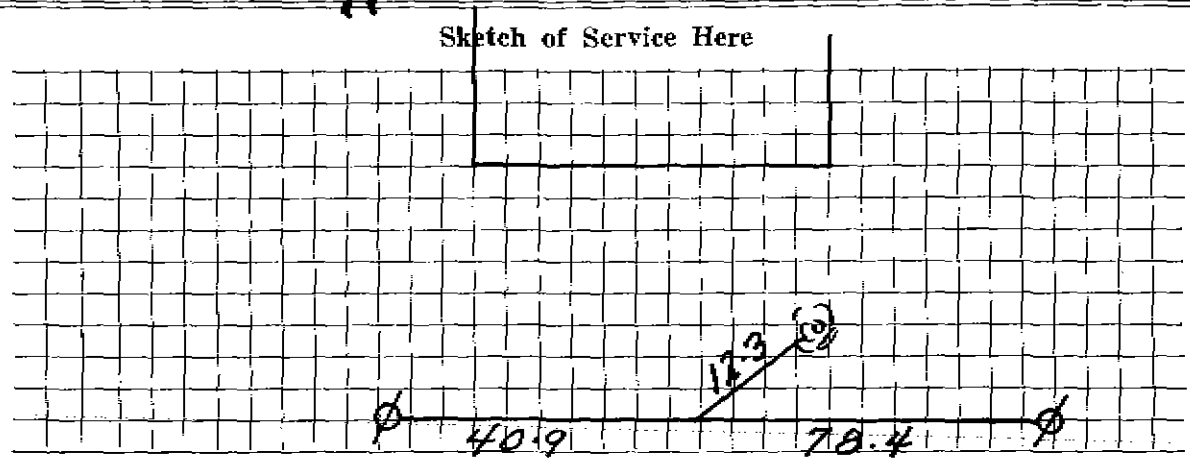

Connection made in _____ Street. Work completed _____ 19

Remarks: This service shots off clockwise
the road is bent so that it look off when it is on