

Albert O. Wilson

Service No.

Address 32 Bertwell Road

Lexington, Mass.

Location 32 Bertwell Road

Kind of Pipe

Size

Size of Main

~~Renewal~~ - ~~NEW SERVICE~~

Main to Curb

Location

Date

Material

Amount

Total

Date

Amount

8/9/74 RENEWED CURB TO  
HOUSE BY DAVE EAGLE  
3/4" COPPER TUBING

Non-Charge

Mar. 23, '78	Labor	17	80
24	"	12	97
30' - 3/4"	Copper Tubing @.255	7	65
1 - 3/4"	x 3/4" Curb-cock	3	68
1 - 3/4"	Adapter	1	50
Shovel 1 1/2 hrs.	@ 7.00	10	50
Compressor 2 hrs.	@ 1.75	3	50
Trucking 2 hrs	@.75	1	50
Patching 20 x 3		20	00

79 10

Labor

DATE \_\_\_\_\_

### TOWN OF LEXINGTON - BOARD OF PUBLIC WORKS

## WATER DIVISION

The undersigned applies for a supply of water at No..... St. and hereby agrees to comply with the rules and regulations as now, or at any future time, established by the Board of Selectmen.

Am't of Estimate \$.....

Owner .....


Am't Paid \$.....

Address .....

Builder .....

.....

Sketch of Service Here

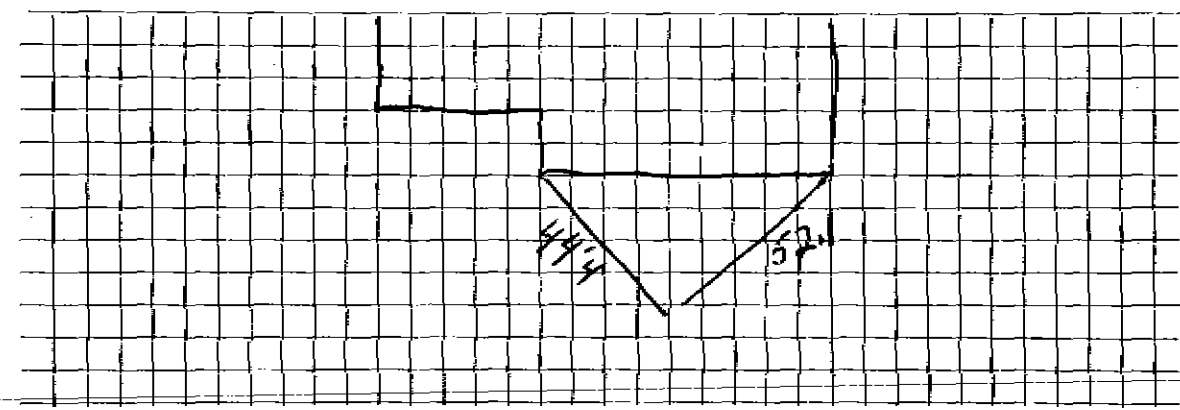

Connection made in ..... Street.

Work completed .....19

Remarks: