

Name

Service No. 259

Address

35 Bertwell Rd.

Location

35 Bertwell Rd.

Kind of Pipe

Size

Size of Main

Repair—Renewal—New Service

Location

Date

Material

Amount

Total

Date

Amount

Labor

DATE _____

TOWN OF LEXINGTON—BOARD OF PUBLIC WORKS
WATER DIVISION

The undersigned applies for a supply of water at No. _____ St. and hereby agrees to comply with the rules and regulations as now, or at any future time, established by the Board of Selectmen.

Am't. of Estimate \$ _____

Owner

N.S. Hooper

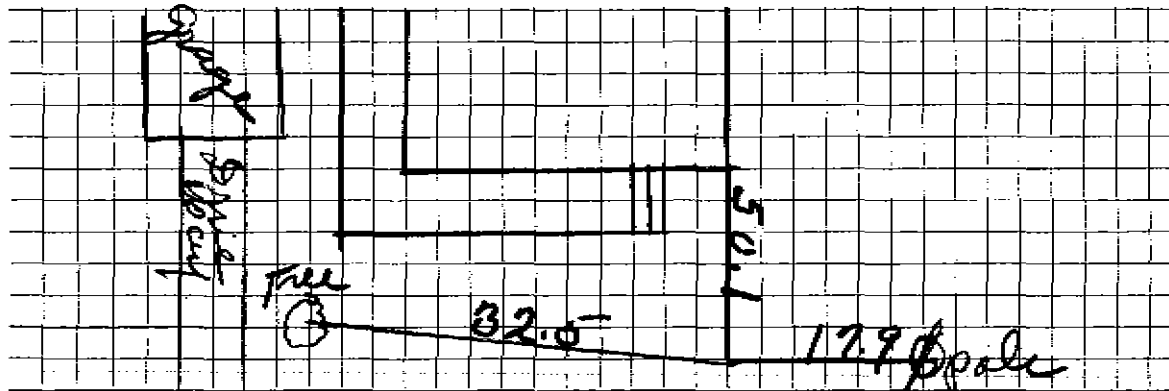
Am't. Paid \$ _____

Address

35 ~~St.~~ Bertwell Rd.

Builder _____

Sketch of Service Here

Connection made in Bertwell Rd. Street.

Work completed _____

19

Remarks: