

Name

Service No. 260

Address 36 Bertwell Rd.

Location 36 Bertwell Rd

Kind of Pipe

Size

Size of Main

Repair—Renewal—New Service

Location

Date

Material

Amount

Total

Date

Amount

7-21-93

Inside
~~at Pipe~~
30' 3/4 COPPER
3/4" UAL6

KIRKLAND & SHAW

Labor

6-11-93

Outside
28' - 3/4 Copper
1 3/4 Comp. Corp Adapt
1 3/4 Comp Curb STOP
1 Cop - Iron Adapt.
1 Box + Rod

DATE _____

TOWN OF LEXINGTON—BOARD OF PUBLIC WORKS

WATER DIVISION

The undersigned applies for a supply of water at No. _____ St. and hereby agrees to comply with the rules and regulations as now, or at any future time, established by the Board of Selectmen.

Am't. of Estimate \$ _____


Owner W. L. Pring

Am't. Paid \$ _____

Address 36 ~~58~~ Bertwell Rd.

Builder _____

Sketch of Service Here

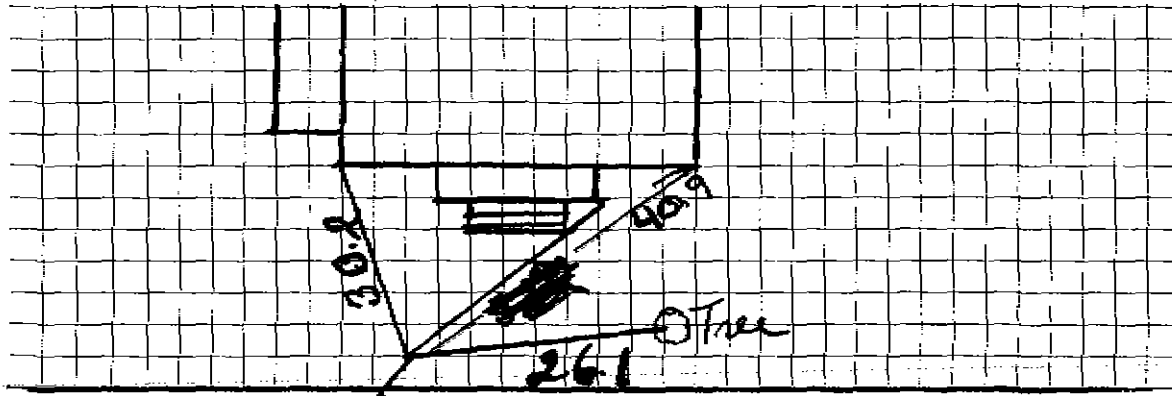

Connection made in Bertwell Rd Street.

Work completed _____ 19

Remarks:

Pole