

Name Harold Furness

Service No. 3 3101

Address 39 Bertwell Road

#2580

Location 39 Bertwell Road

Kind of Pipe

Size

Size of Main

~~Repair~~ ~~Renewal~~ ~~New Service~~

Location

Date

Material

Amount

Total

Date

Amount

Jan. 14, '46

Labor 2 70

2 70

10% Overhead

27

47' -  $\frac{3}{4}$ " Copper Tubing

8 99

1 -  $\frac{3}{4}$ " C x  $\frac{1}{2}$ " I.S.H. Stop & Waste

2 35

1 -  $\frac{3}{4}$ " C. Union (3 parts)

1 04

Trucking 1 hr.

75

Patching 7 x 3

2 66

18 76

Trench Dug by Owner

Jan. 7 '46

*Reported*

25 00

Jan. 24 '46

*Repaired*

6 24

Non-Charge

18 76

Jan. 14, '46

Labor

20 03

17' -  $\frac{3}{4}$ " Copper Tubing

3 25

1 -  $\frac{3}{4}$ " C Corp-cock

3 02

1 -  $\frac{3}{4}$ " C x  $\frac{3}{4}$ " C. Curb-cock

3 02

1 Box & Rod

1 65

Compressor 3 hrs. 31.75

3 50

Trucking 1 hr. 2.75

75

35 22

Labor

DATE \_\_\_\_\_

# TOWN OF LEXINGTON—BOARD OF PUBLIC WORKS

## WATER DIVISION

The undersigned applies for a supply of water at No. \_\_\_\_\_ St. and hereby agrees to comply with the rules and regulations as now, or at any future time, established by the Board of Selectmen.

Am't. of Estimate \$ \_\_\_\_\_


Owner \_\_\_\_\_

Am't. Paid \$ \_\_\_\_\_

Address \_\_\_\_\_

Builder \_\_\_\_\_

Sketch of Service Here

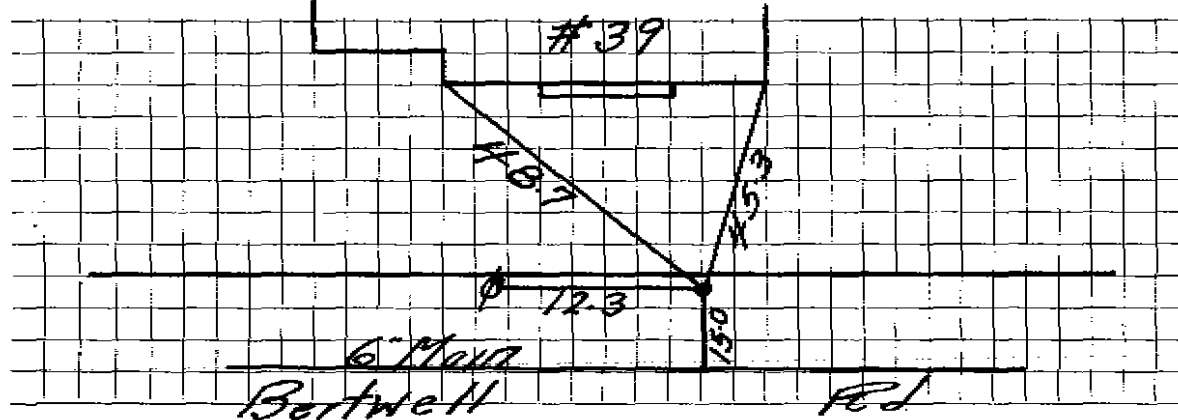

Connection made in \_\_\_\_\_ Street.

Work completed \_\_\_\_\_ 19

Remarks: