

WATER SERVICE RECORD

Name T. M. Lescalleet, Jr.

Service No. 2

Address 42 Bertwell Road

Location

~~Repair~~ Renewal ~~New Service~~ W.O. #267


MAY 21 1979

Date	Material	Amount	Total	Date	Amount
4/2/79	Labor	100.72		3-9-79	400.00
	10% O.H.	10.07	110.79		226.13
33'	3/4" Copper tubing @.74		24.42		123.87
1	3/4" Wheel Stop		17.10		OUTSIDE W.O. #317
1	3/4" x 1/2 Reducer		1.56	4-2-79	Labor
1	5/8" Tailpiece		1.00	4-24-79	"
2	hrs. Trucking @ 3.00		6.00	29'	3/4" Copper tubing
2	hrs. Backhoe @ 6.50		13.00	1	3/4" adapter Corp
			173.87	1	3/4" curb stop
					Patch 26 x 6
				6	hrs. Trucking
				2	hrs. Town Shovel
				1/2	hr. Roller
				1/2	hr. Compressor

DATE _____

TOWN OF LEXINGTON — BOARD OF PUBLIC WORKS
WATER DIVISION

Sketch of Service Here

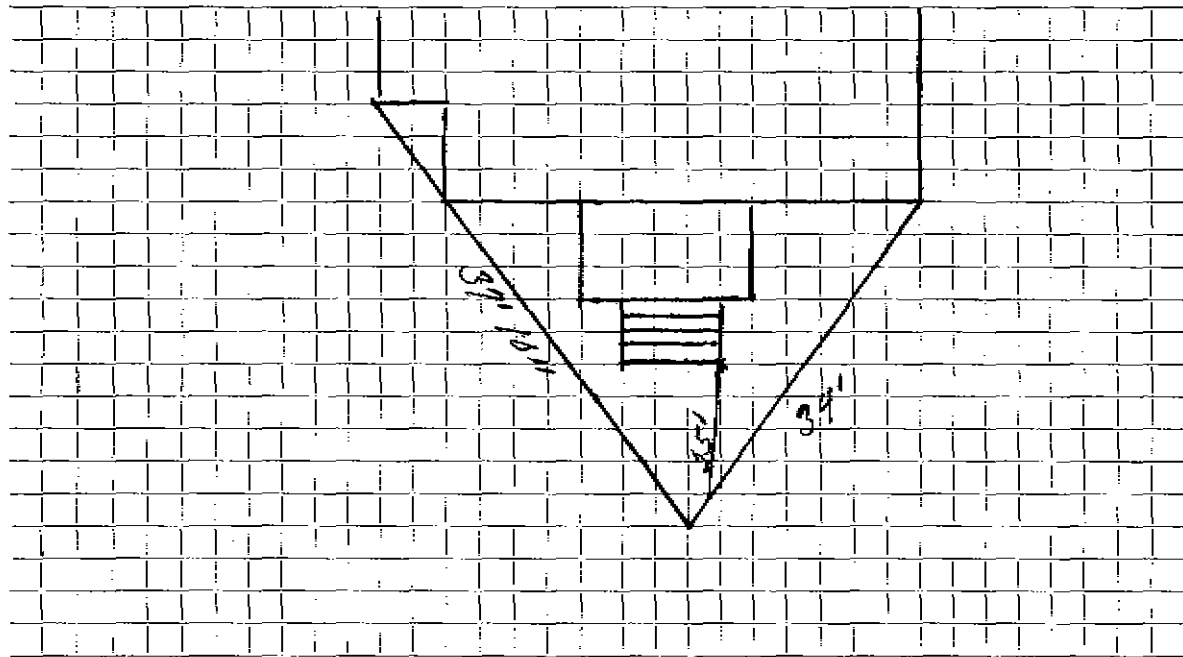

Connection made in Street. Work completed

Remarks: .. 33' 3/4" Copper Inside

..... 29' 3/4" Copper Outside

.....