

WATER SERVICE RECORD

Name **Norman W. Bell**

Service No. **26**

Address **43 Bartwell Road**

Location

~~Repair~~ ~~Renewal~~ **New Service** *WO # 8636*

JUN 29 1964


Date	Material	Amount	Total	Date	Material	Amount	
5/21/64	Labor	2 31		4-8-64	Deposit	50 00	
	10% O.H.	23	2 54	6-29-64	Refund	20 29	
	50' 3/4" Copper Tubing @ .42		21 00			29 71	
	1 3/4" Cx 1/2" I.W.H. Stop & Waste		6 17				
			29 71	5/21/64	Labor	2 22	
					14' 3/4" Copper Tubing @ .42	5 88	
					1 3/4" C Corp Cock	4 91	
					1 3/4" C Curb Cock	6 28	
					1 Bow & Rod	4 90	
					1 3/4" Straight Tailpiece	50	
					1 3/4" Offset Tailpiece	50	
						25 19	
				* Applied to SH # 4019			

TOWN OF LEXINGTON — BOARD OF PUBLIC WORKS

WATER DIVISION

DATE _____

Sketch of Service Here

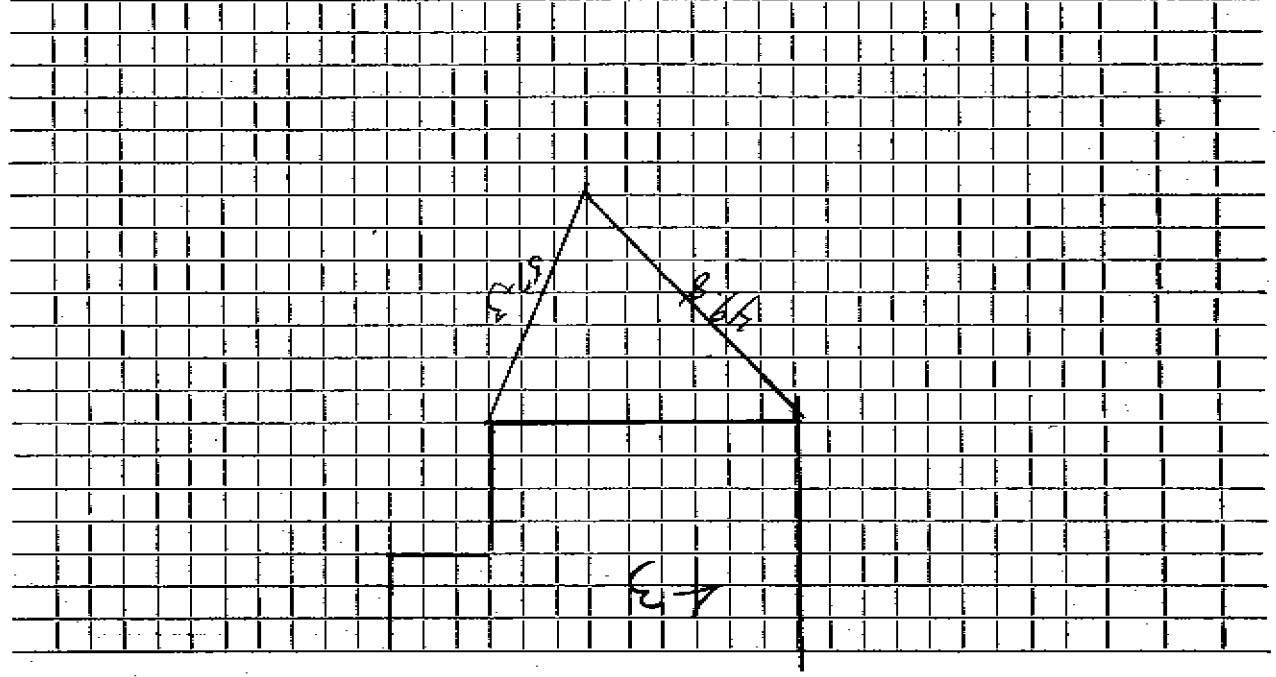

Work completed

Street

Connection made in

Remarks: