

WATER SERVICE RECORD

Name

Service No.

Address

44 Bertwell Road


Location

~~Repair-Renewal~~ New Service

Date	Material	Amount	Total	Date	Amount
4/10/28	34' 1" C.L. Pipe @.27				
BISIKO					
6-23-84	33' 3/4 COPPER				
	1 3/4 UNION				
					OUTSIDE
				12/15/87	28' 3/4" Copper
					1 3/4" Corp.
					1 3/4" Curb Stop
					1 1" Iron x 3/4 C. Adpt.
					Box & Rod

TOWN OF LEXINGTON — BOARD OF PUBLIC WORKS
WATER DIVISION

Sketch of Service Here

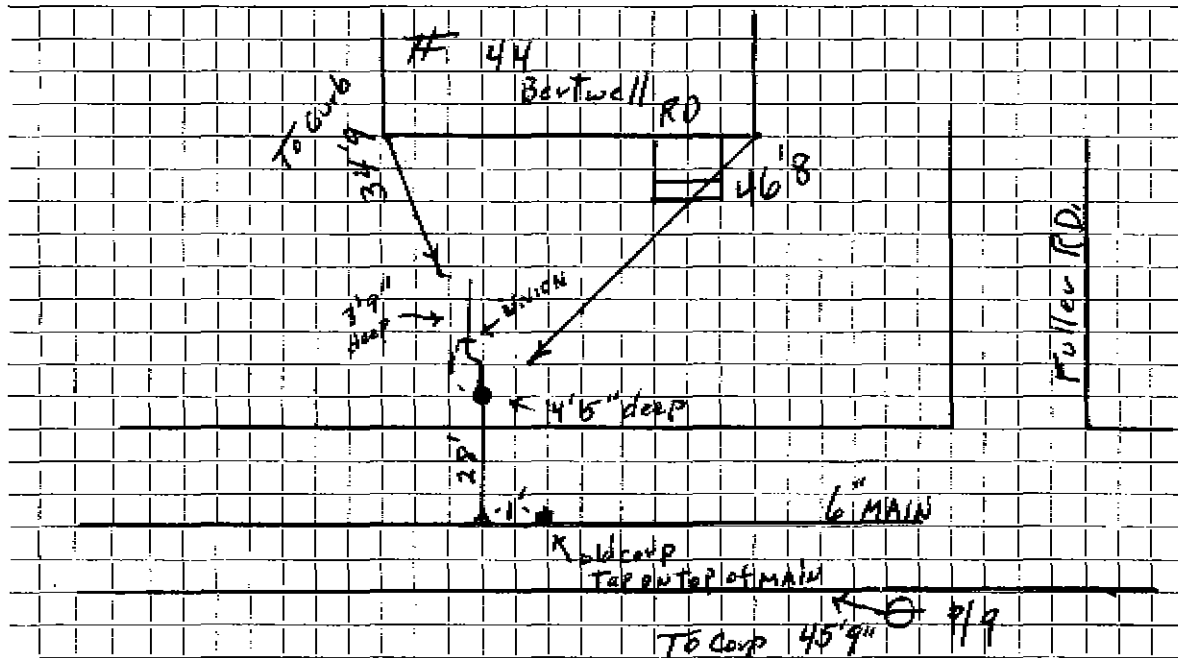

Connection made in Street. Work completed

Remarks: 8" Drain 2" ABOVE WATER MAIN