

Name Gordon Chase  
 Address 60 Bertwell Road  
 Lexington, Mass.

Service No.

# 4192  
 3286

Location 60 Bertwell Road

Kind of Pipe

Size

Size of Main

~~Repair - Renewal~~ - New Service

Location

Date	Material	Amount	Total	Date	Amount
June 18, '47	Labor	8 07		June 13, '47	35 00
19	"	2 10	10 17	Sept 23, '47	7 65
	10% Overhead		1 02		25 35
	38' - 3/4" Copper Tubing @.27		10 26	June 18, '47	33 58
	1 - 3/4" C x 1/2" I.W.H. S & W		3 15	19	50 47
	Trucking 1 hr. @.75		75	28' - 3/4" Copper Tubing @.27	7 56
			25 35	1 - 3/4" C Corp-cock	3 00
				1 - 3/4" C x 3/4" C Curb-cock	3 68
				1 - Box & Rod	3 35
				1 - 1/2" Straight Tail Piece	50
				1 - 1/2" Offset Tail Piece	50
				Compressor 4 hrs. @1.75	7 00
				Trucking 1 hr. @.75	75
	Labor				110 39

DATE \_\_\_\_\_

# TOWN OF LEXINGTON—BOARD OF PUBLIC WORKS

## WATER DIVISION

The undersigned applies for a supply of water at No. \_\_\_\_\_ St. and hereby agrees to comply with the rules and regulations as now, or at any future time, established by the Board of Selectmen.

Am't. of Estimate \$ \_\_\_\_\_


Owner \_\_\_\_\_

Am't. Paid \$ \_\_\_\_\_

Address \_\_\_\_\_

Builder \_\_\_\_\_

Sketch of Service Here

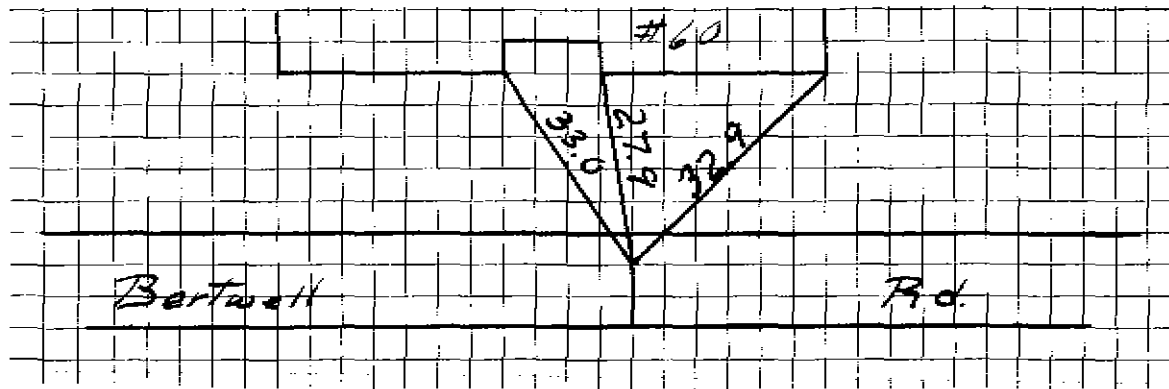

Connection made in \_\_\_\_\_ Street.

Work completed \_\_\_\_\_ 19

Remarks: