

Name Henry E. Andrews

Service No.

Address 61 Bertwell Road

#3629

3510

Lexington, Mass.

Location 61 Bertwell Road

Kind of Pipe

Size

Size of Main

~~Repair - Renewal~~ - New Service **Com. 8-23-48**

Location

Date	Material	Amount	Total	Date	Amount
Jul. 17, '48	Labor	2 10	2 10	July 6, 48	20 00
	10% Overhead		21		
	53' - 3/4" Copper Tubing @.255	13 52			
	1 - 3/4" C x 1/2" I.W.H. 3 & W	3 15			
	Trucking 1 hr. @.75	75	19 73		
				Jul. 17, '48	
				Labor	2 10
				17' - 3/4" Copper Tubing @.255	4 34
				1 - 3/4" C Corp-cock	3 00
				1 - 3/4" C x 3/4" C Gurb-cock	3 68
				1 - Box & Rod	3 55
				1 - 3/8" Straight Tail Piece	30
				1 - 1/2" Offset Tail Piece	30
				Trucking 1 hr. @.75	75
					18 02
	Labor				

Deposited

Non-Charge

Hadley Press, Inc., Lexington

DATE _____

TOWN OF LEXINGTON—BOARD OF PUBLIC WORKS

WATER DIVISION

The undersigned applies for a supply of water at No. _____ St. and hereby agrees to comply with the rules and regulations as now, or at any future time, established by the Board of Selectmen.

Am't. of Estimate \$ _____


Owner _____

Am't. Paid \$ _____

Address _____

Builder _____

Sketch of Service Here

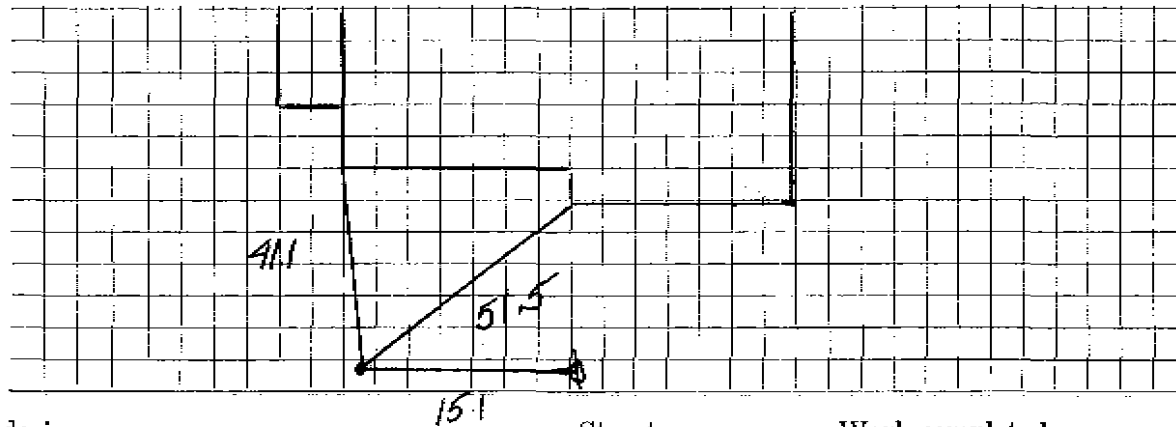

Connection made in _____ Street.

Work completed _____ 19

Remarks: