

Name

Service No.

265

Address 65 Bertwell Rd.

3710

5471

Location 65 Bertwell Rd.

Kind of Pipe

Size

Size of Main

Repair—Renewal—New Service

Location

Date	Material	Amount	Total	Date	Material	Amount
	Inside C.L. Pipe			6-14-93	Outside 13'-3/4 Copper 1 3/4 Comp Corp Adapt 1 3/4 Comp. Curb Stop 1 Cop - Iron Adapt 1 Box + Reel	
	Labor					

Hadley Press, Inc., Lexington

DATE _____

TOWN OF LEXINGTON—BOARD OF PUBLIC WORKS

WATER DIVISION

The undersigned applies for a supply of water at No. _____ St. and hereby agrees to comply with the rules and regulations as now, or at any future time, established by the Board of Selectmen.

Am't. of Estimate \$ _____


Owner Hadley.

Am't. Paid \$ _____

Address 65 ~~St~~ Bertwell Rd.

Builder _____

Sketch of Service Here

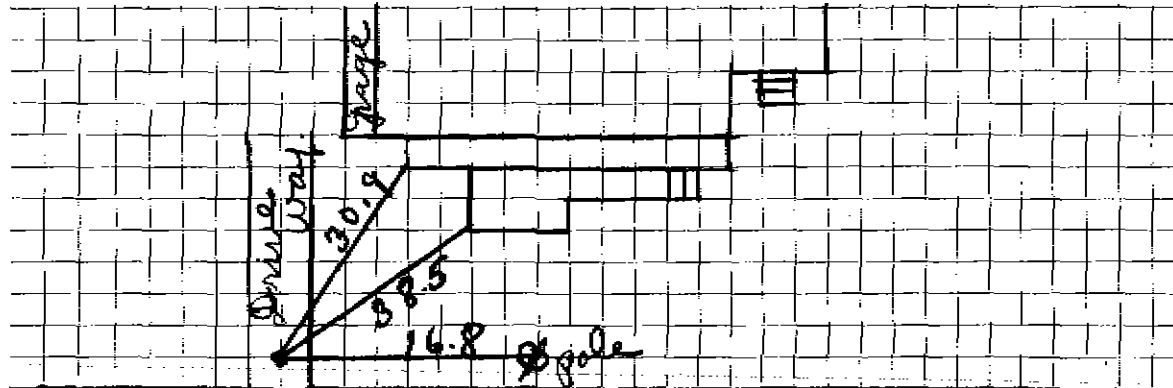

Connection made in Bertwell Rd. Street.

Remarks:

Work completed _____ 19