




TOWN OF LEXINGTON - BOARD OF PUBLIC WORKS  
WATER DIVISION

SKETCH OF SERVICE HERE

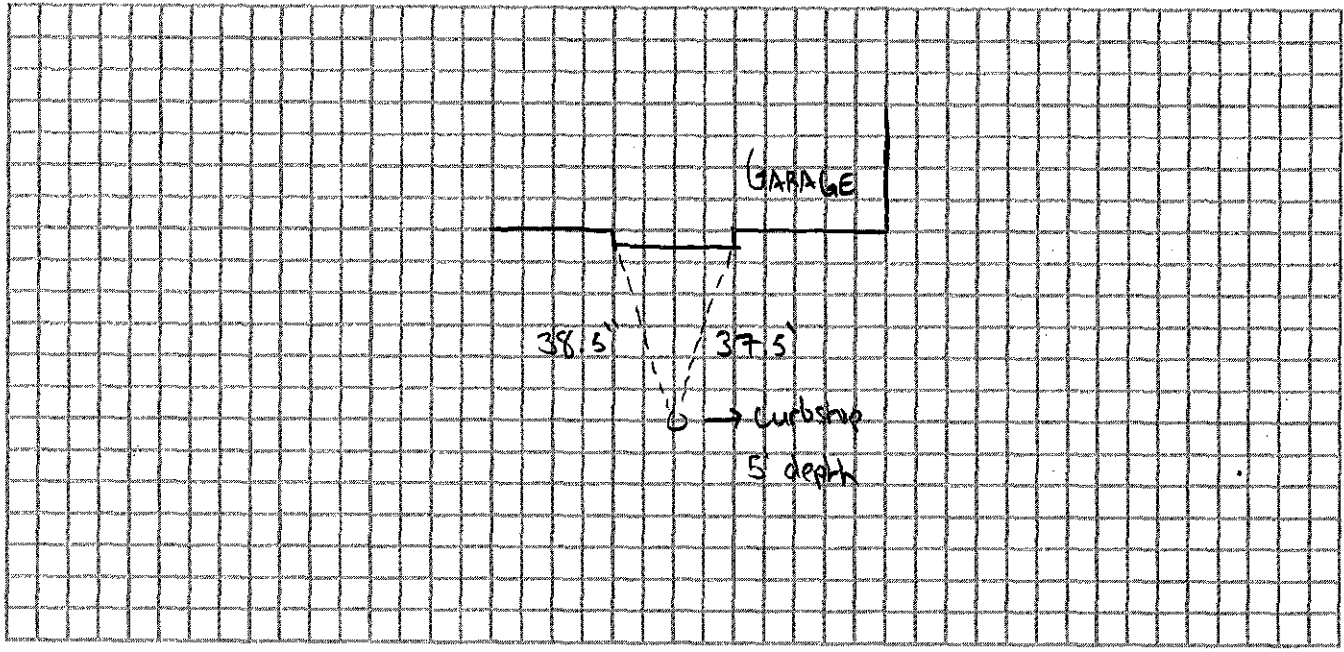

Connection made in: BERTWELL RD Street. Work completed:

Remarks: INSTALLED BY IOWA EXCAVATING