

Name

Service No.

266

Address

69 Bertwell Rd.

3834

Location

69 Bertwell Rd.

Kind of Pipe

Size

Size of Main

Repair—Renewal—New Service

Location

Date

Material

Amount

Total

Date

Amount

Inside  
C.L. Pipe

6-15-93

Outside :

8'- 3/4 Copper

1 3/4 Comp Corp. Adapt.

1 3/4 Comp. Curb Stop

1 Cop-Fron

1 Box + Rod

Labor

DATE \_\_\_\_\_

# TOWN OF LEXINGTON—BOARD OF PUBLIC WORKS WATER DIVISION

The undersigned applies for a supply of water at No. \_\_\_\_\_ St. and hereby agrees to comply with the rules and regulations as now, or at any future time, established by the Board of Selectmen.

Am't. of Estimate \$ \_\_\_\_\_


Owner \_\_\_\_\_

Am't. Paid \$ \_\_\_\_\_

Address 69 Bartwell Rd

Builder \_\_\_\_\_

Sketch of Service Here

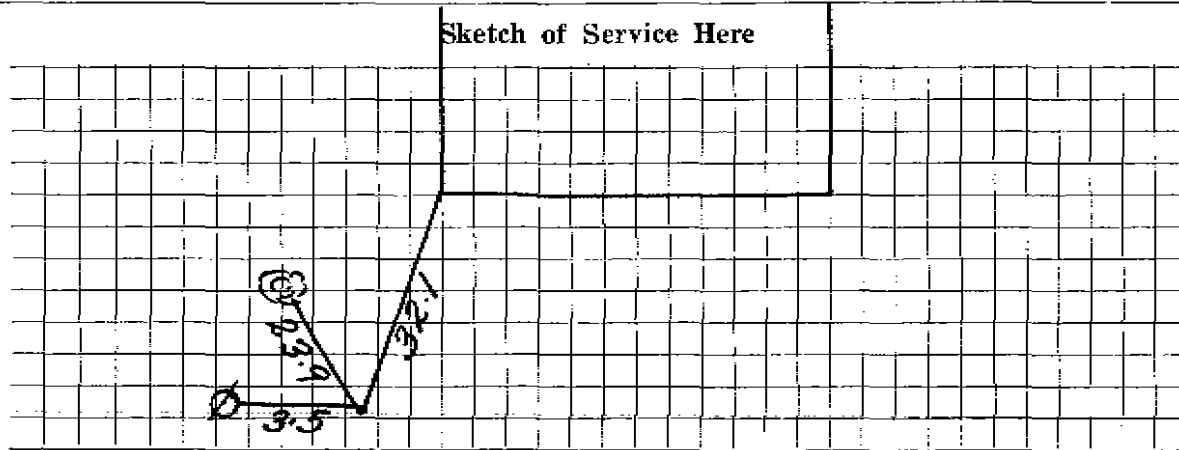

Connection made in \_\_\_\_\_ Street.

Work completed \_\_\_\_\_ 19

Remarks: