

Name

Service No. **267**  
**#1566**

Address **75 Bertwell Rd.**

Location **75 Bertwell Rd.**

Kind of Pipe

Size

Size of Main

Repair—Renewal—New Service

Location

Date	Material	Amount	Total	Date	Amount
	Inside C.L. Pipe			6-16-93	
	Labor				
				Outside	
				7'-3/4 Copper	
				1 3/4 Comp Corp Adapt.	
				1 3/4 Comp Curb STOP	
				1 Cop - Iron	
				1 Box + Rod.	

DATE \_\_\_\_\_

# TOWN OF LEXINGTON—BOARD OF PUBLIC WORKS

## WATER DIVISION

The undersigned applies for a supply of water at No. \_\_\_\_\_ St. and hereby agrees to comply with the rules and regulations as now, or at any future time, established by the Board of Selectmen.

Am't. of Estimate \$ \_\_\_\_\_


Owner Ralph Tibbets

Am't. Paid \$ \_\_\_\_\_

Address 75 Bertwell Rd.

Builder \_\_\_\_\_

Sketch of Service Here

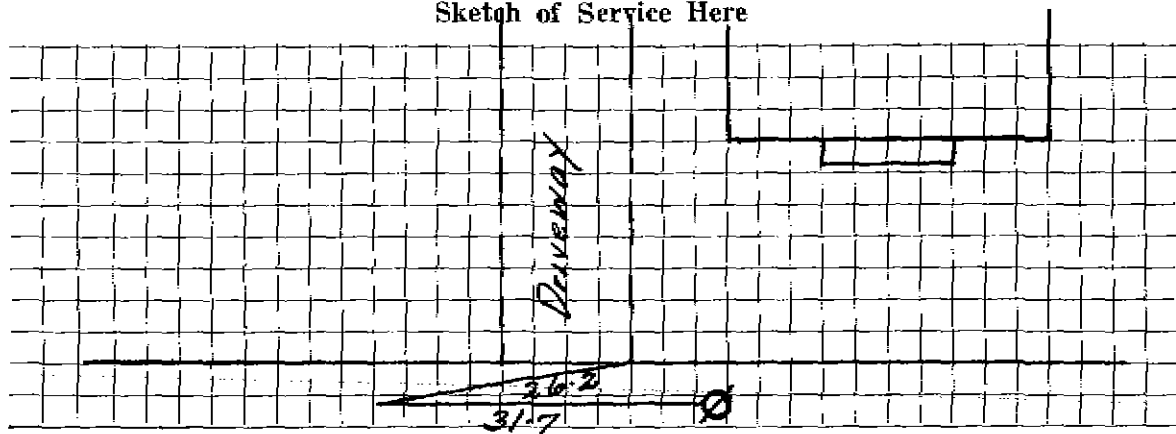

Connection made in \_\_\_\_\_ Street.

Work completed \_\_\_\_\_ 19

Remarks: