

Name Leiland G. McConchie
 Address 104 North St., Lexington
 #76 Bertwell Rd.

Service No. ~~71~~ 268
 #4272
 #6762

Location 76 Bertwell Road

Kind of Pipe

Size

Size of Main

Repair—Renewal—New Service

Location

Date 1940	Material	Amount	Total	Date	Amount
Oct. 22	8 hrs. @ 60¢	4 80		October 10, 1940	18 00
Com 11/18/40	10 @ Overhead	48	5 28	November 25, 1940	3 93
	28' 3/4" Copper tubing @ 18¢		5 04		14 07
	1 3/4" C.x 1/2" I.S. & W.		2 25		
	2 hr. trucking @ 75¢		1 50		
			\$14 07		
	Labor				

Deposited
 Returned

Hadley Press, Inc., Lexington

DATE July 12, 1910

TOWN OF LEXINGTON—BOARD OF PUBLIC WORKS

WATER DIVISION

The undersigned applies for a supply of water at No. 76 Bertwell Rd. St. and hereby agrees to comply with the rules and regulations as now, or at any future time, established by the Board of Selectmen.

Am't. of Estimate \$ 10.00

Owner Kellogg G. McConchie


Am't. Paid \$ _____

Address 104 North St

Builder Kellogg G. McConchie

Lexington Mass

Sketch of Service Here

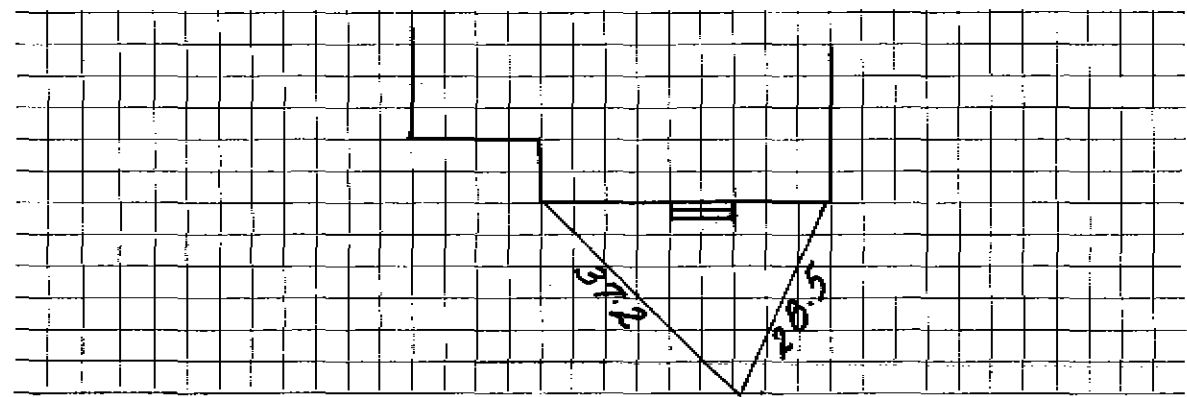

Connection made in _____ Street. Work completed _____ 19

Remarks: