

Name Walter Bosselman
 Address 6 Wildwood Road, Medford, Mass.
 78 Bertwell Rd.

Service No. 63 269

#2954

Location 78 Bertwell Road.

Kind of Pipe Size Size of Main
~~Repair~~ ~~Renewal~~ New Service Location

Date
1940

Material

Amount

Total

Date
1940

Amount

Oct. 24

13 hrs. @ 60¢

10 80

13 55

Oct 3 Deposited
 November 25, 1940 Refunded

40 00

Com 11/18/40

5 " @ 55¢

2 75

10% Overhead

1 35

15 23

34' 3/4" Coppertubing @ 18¢

6 12

24 77

1 3/4" C.x 1/2" I.S. & W.

2 25

2 hrs. trucking @ 75¢

1 50

24 77

Labor

DATE Sept. 28, 1940

TOWN OF LEXINGTON—BOARD OF PUBLIC WORKS

WATER DIVISION

The undersigned applies for a supply of water at No. 78 Bertwell Rd. and hereby agrees to comply with the rules and regulations as now, or at any future time, established by the Board of Selectmen.

Am't. of Estimate \$ 12.00

Owner Walter Gosselmann


Am't. Paid \$ _____

Address 6 Wildwood Rd.

Builder _____

Medford Mass.

Sketch of Service Here

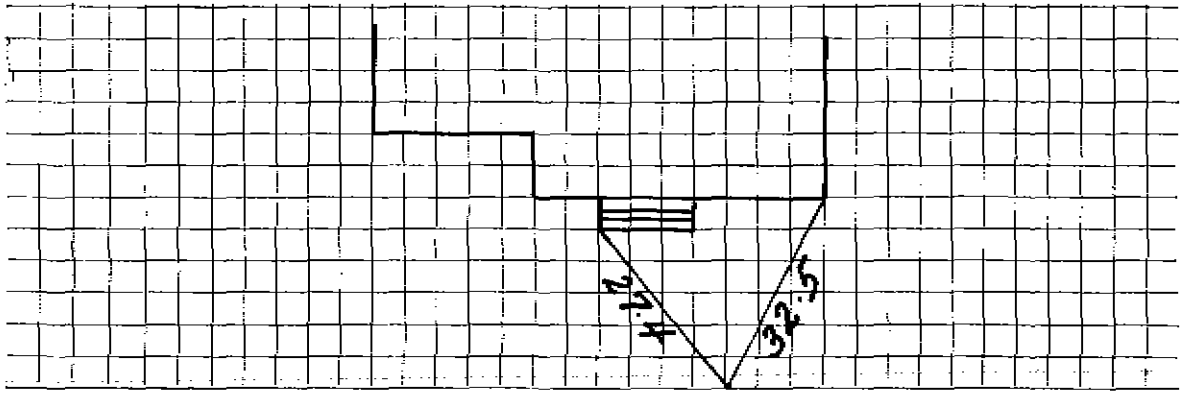

Connection made in _____ Street. Work completed _____ 19

Remarks: