

WATER SERVICE RECORD

Name Nicholas DeBonis

Service No. 165

Address 79 Bertwell Road

#1972

Location

#1973

~~Repair - Remount~~ New Service WO #7728

Comm 12-1-63


Date	Material	Amount	Total	Date	Amount	
11-15-62	Labor	1.78		11-13-62	Deposit	50.00
	10% O.H.	.18	1.96	1-17-63	Refund	23.81
43'	3/4" Copper tubing @.42		18.06			26.19
1	3/4" C x 1/2 I.W.H. Stop & Waste		6.17		NON CHARGE	
			26.19	11-15-62	Labor	2.24
				12'	3/4" Copper tubing @.42	5.04
				1	3/4" G Corp Cock	4.91
				1	3/4" G Curb Cock	6.28
				1	Box & Rod	4.90
				1	1/2 Straight tailpiece	.50
				1	1/2 Offset tailpiece	.50
						24.37

DATE _____

TOWN OF LEXINGTON — BOARD OF PUBLIC WORKS

WATER DIVISION

Sketch of Service Here

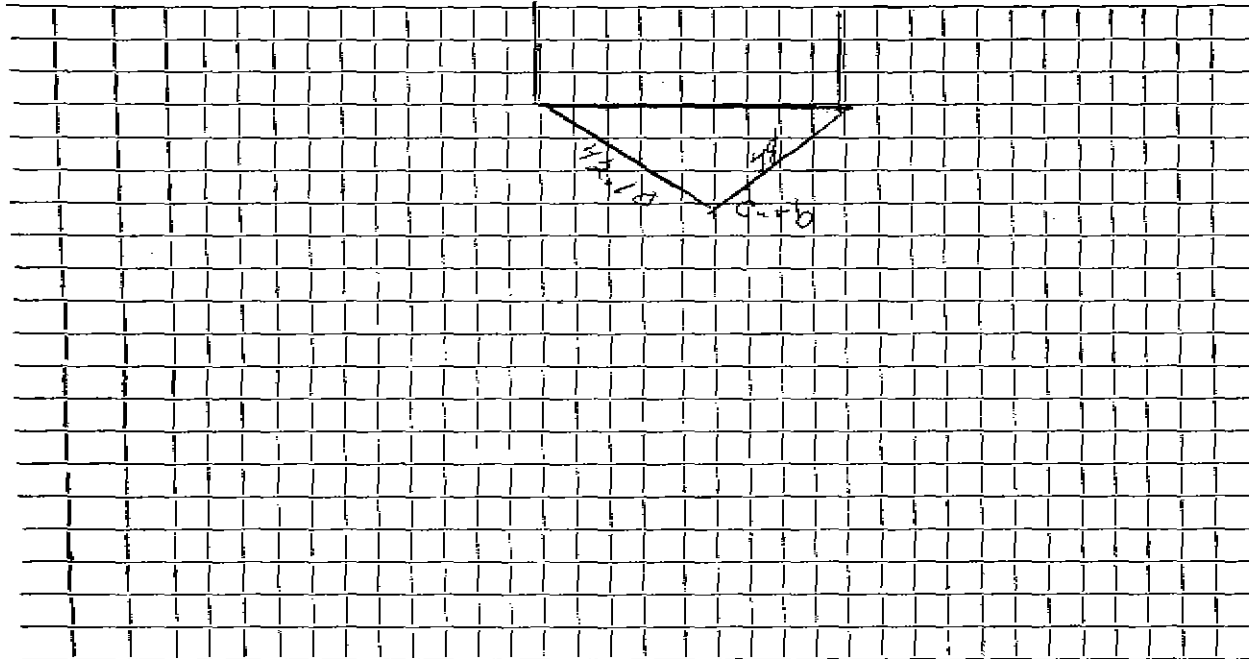

Connection made in Street. Work completed

Remarks:

.....
.....