

Name E. E. MacPhee

270
Service No. 8 - 1941

Address 16 Vaille Avenue, Lexington
83 Bertwell Rd.

Location 83 Bertwell Road

Kind of Pipe

Size

Size of Main

Repair—Renewal—New Service

Location

Date	Material	Amount	Total	Date	Amount
1/13/41	2 hrs. @ 80¢	1 20			
<i>Com 210-41</i>	10% Overhead	12	1 32	<i>Jan. 11, 1941 Deposited</i>	16 00
	40' 3/4" Copper tubing @ 19¢	7 60	7 60	<i>January 19, 1941 Refund</i>	33
	1 3/4" C. S. & W.	2 25	2 25		15 67
	1 hr. trucking @ 75¢	75			
	Construction charge	3 75	3 75		
			15 67		
	Labor				

Madley Press, Inc., Lexington

DATE _____

TOWN OF LEXINGTON—BOARD OF PUBLIC WORKS

WATER DIVISION

The undersigned applies for a supply of water at No. _____ St. and hereby agrees to comply with the rules and regulations as now, or at any future time, established by the Board of Selectmen.

Am't. of Estimate \$ _____


Owner _____

Am't. Paid \$ _____

Address _____

Builder _____

Sketch of Service Here

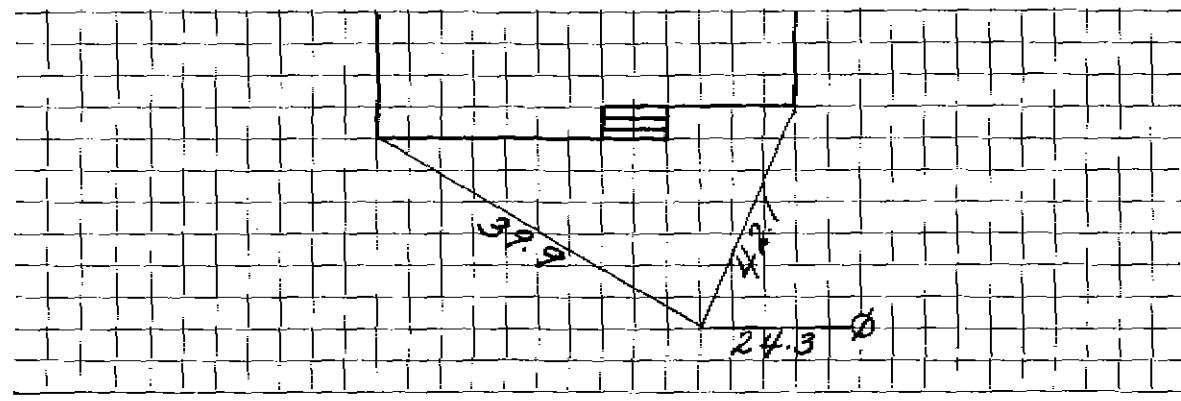

Connection made in _____ Street. Work completed _____ 19

Remarks: