

Name Leeland G. McConchie

Service No. 90 271

Address 104 North Street, Lexington  
84 Bertwell Rd.

#6317

Location 84 Bertwell Road

Kind of Pipe

Size

Size of Main

Repair—Renewal—New Service

Location

Date	Material	Amount	Total	Date	Amount
Nov. 21, 1940	10 hrs. @ 60¢	6 00		November 1940 Deposited	18 00
<i>Jan 17-31, 1940</i>	10% Overhead	60	6 60	Dec 31, 1940 Refund	82
	32' 3/4" Copper tubing @ 19¢		6 08		
	1 3/4" C.S.& W.		2 25		
	3 hrs. trucking @ 75¢		2 25		
			<u>17 18</u>		<u>17 18</u>
	Labor				

DATE Nov. 8. 1940

TOWN OF LEXINGTON—BOARD OF PUBLIC WORKS  
WATER DIVISION

The undersigned applies for a supply of water at No. 84 Bertwood Rd St. and hereby agrees to comply with the rules and regulations as now, or at any future time, established by the Board of Selectmen.

Am't. of Estimate \$ 18.50

Owner Seland G. M Conchie


Am't. Paid \$ \_\_\_\_\_

Address 104 North St.

Builder owner will dig

Lexington

Sketch of Service Here

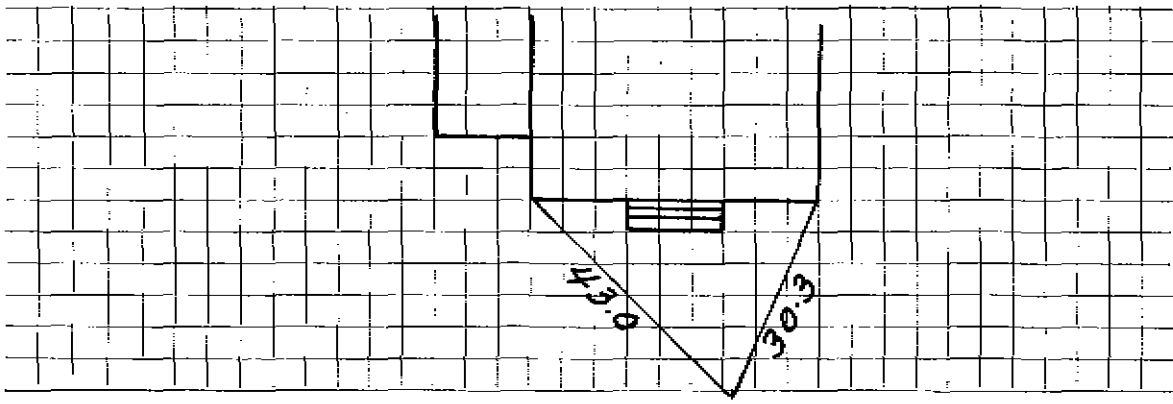

Connection made in \_\_\_\_\_ Street. Work completed \_\_\_\_\_ 19

Remarks: