

WATER SERVICE RECORD

# 59  
# 6272  
275

Name Louis Mead

Service No.

Address 1 Berwick Rd., Lexington

Location

Repair—Renewal—New Service

Com. 11-21-55

Date	Material	Amount	Total	Date	Amount
9/9/55	Labor	18 20		8-19-55 Deposited	75 00
	10% Overhead	1 82	20 02	12-19-55 Paid	7 12
	70'-1" Copper tubing@.4584		32 09		Non Charge
	1-1" Cx 3/4" I.S.F. stop & waste	4 50	9/9/55	Labor	7 10
	1-1" Cx 1" C. Union (3 part)	2 26	27'-1" Copper tubing@.4584		12 38
	3 hrs. Littlefield Shovel @7.50	22 50	1-1" Cx 1" C Curb Cock		6 80
	1 hr. trucking @.75	75	1-1" C Corp Cock		5 61
		82 12	1 Box & Rod		3.90
			1-3/4" straight tail piece		50
			1-3/4" offset tail piece		50
			27x3 patching		27 00
			1-2/3 hrs. Littlefield Shovel @ 7.50		12 00
			1 hr. trucking @.75		75
					76 54

121


DATE \_\_\_\_\_

TOWN OF LEXINGTON — BOARD OF PUBLIC WORKS

WATER DIVISION

Sketch of Service Here

# 1 BERWICK RD.

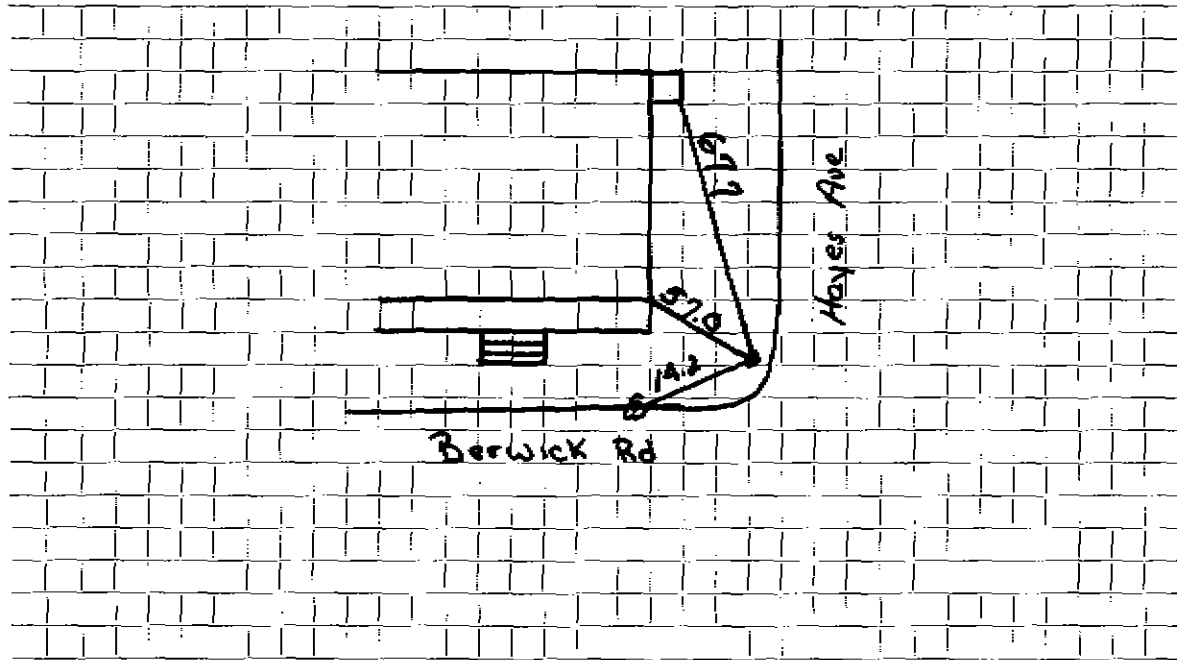

Connection made in ..... Street. Work completed .....

Remarks: .....  
.....  
.....