

WATER SERVICE RECORD

Name Frank Wilkins

Service No. 29

Address 10 Berwick Road

Location

~~Repair~~—Renewal—~~New Service~~

SEP 22 1969


Date	Material	Amount	Total	Date	Amount
7/28/69	Labor	29 70		7-14-69	Deposit 210 00
8/1/69	"	16 80	46 50	9-22-69	Retard 75 62
	10% O.H.		4 65		134 38
60'	3/4" Copper pipe .79		47 40		<u>OUTSIDE</u>
1	3/4" W.H.S.W.		11 13	7/28/69	Labor 89 10
1	Yd. Loam		3 50	9/2/69	" 51 54
2	Lbs. Grass seed 1.10		2 20	30'	3/4" Copper pipe .79 23 70
2	Hrs. Shovel 6.50		13 00	1	3/4" Corp. 9 57
2	" Trucking 3.00		6 00	1	3/4" Curb cock 11 32
			134 38	1	Box & Rod 5 10
				3 1/2	Ton Hot top 5.80 20 30
				4	Hrs. Shovel 4.00 16 00
				4	" Trucking 3.00 12 00
				"	" " 1.50 75
				1	" Compressor 3 00
				1	" Trailer 2 00
				1	" Roller 3 00
					247 38

DATE _____

TOWN OF LEXINGTON -- BOARD OF PUBLIC WORKS

WATER DIVISION

Sketch of Service Here

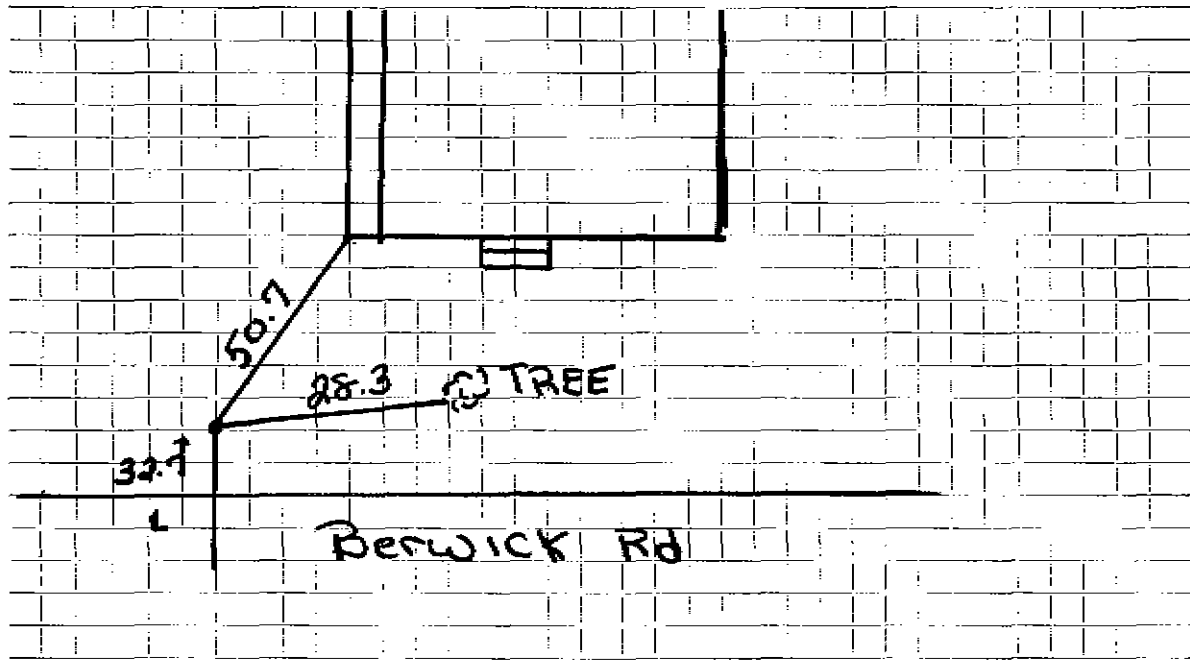

Connection made in Street. Work completed

Remarks:
.....
.....