

Name John Paratore

Service No. 284 42

Address 11 BERWICK ROAD

#5310

Location 11 Berwick Rd.

Kind of Pipe

Size

Size of Main

Repair—Renewal—New Service

Location NOV 18 1968

Date	Material	Amount	Total	Date	Amount
8/8/68	Labor	39 72		9-23-68	718 00
	"	41 80		11-18-68	221 58
	10% O.H.	8 15	89 67		195 00
55'	3/4" copperpipe @ .79		43 45		
	3/4" wheel handle stop & waste		9 30		
2	Hrs. trucking @ 3.00		6 00		
4	" case shovel @ 12.00		48 00		
			196 42		
	<u>Outside</u>				
8/8/68	Labor	39 72			
	"	41 80	81 52		
1	3/4" corporation		9 57		
1	Labor 3/4" curb cock		11 32		
1	Box & rod		5 10		
11	3/4" copperpipe		8 69		
2	Hrs. trucking @ 1.50		3 00		
4	" Case shovel @ 12.00		48 00		
			167 20		

*Deposit*  
*Refund*

Hadley Press, Inc., Lexington

DATE \_\_\_\_\_

# TOWN OF LEXINGTON—BOARD OF PUBLIC WORKS

## WATER DIVISION

The undersigned applies for a supply of water at No. \_\_\_\_\_ St. and hereby agrees to comply with the rules and regulations as now, or at any future time, established by the Board of Selectmen.

Am't. of Estimate \$ \_\_\_\_\_


Owner C. E. Colleson

Am't. Paid \$ \_\_\_\_\_

Address 11 ~~27~~ Berwick Rd

Builder \_\_\_\_\_

Sketch of Service Here

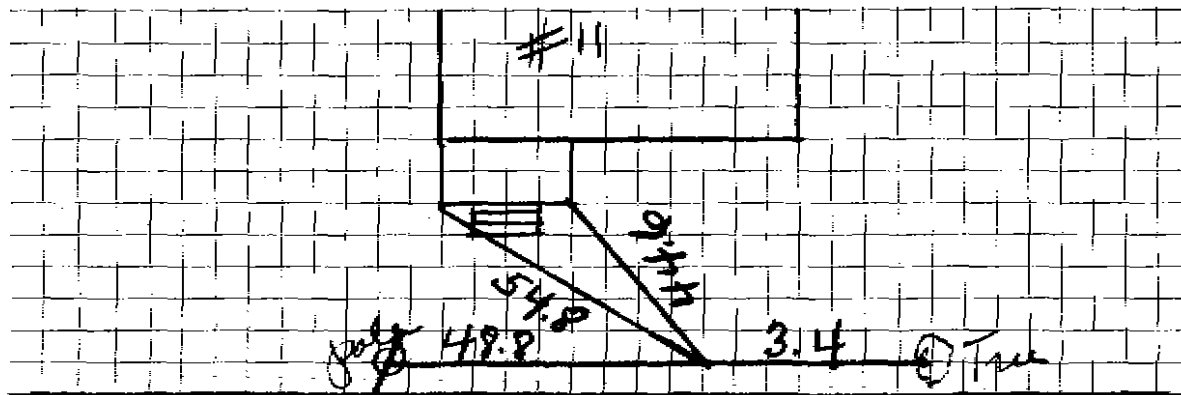

Connection made in Berwick Street. Rd. Work completed \_\_\_\_\_ 19\_\_

Remarks: