

Name Charles Morris

Service No.

114  
285

Address 12 Berwick Road

# 1787

Location 12 Berwick Road

Kind of Pipe

Size

Size of Main

~~REPAIR~~ Renewal - ~~NEW SERVICE~~

*Sept 16/47*

Location

Date	Material	Amount	Total	Date	Amount
Sept. 16, '47	Labor	25 36	25 36	<i>Sept 16 47</i>	40 00
	10% Overhead		2 54	<i>Mar 1. 48</i>	2 98
	43' - 3/4" Copper Tubing @.26	11 18	11 18		42 98
	1 - 3/4" C x 1/2" I.W.H. S & W	3 15	3 15	Sept. 17, '47	51 80
	Trucking 1 hr. @.75		75	18	24 70
			42 98	19	12 70
				30' - 3/4" Copper Tubing @.26	7 80
				1 - 3/4" C Adapter	1 44
				1 - 3/4" C x 3/4" C Cu rb-cock	3 68
				Patching 26 x 3	26 00
				Trucking 1 hr. @.75	75
					128 87
	Labor				

*Deposited*  
*paid*

Non-Charge

*Charles Morris*

DATE \_\_\_\_\_

TOWN OF LEXINGTON – BOARD OF PUBLIC WORKS

**WATER DIVISION**

The undersigned applies for a supply of water at No. .... St. and hereby agrees to comply with the rules and regulations as now, or at any future time, established by the Board of Selectmen.

Am't of Estimate \$.....


Owner .....

Am't Paid \$.....

Address .....

Builder .....

Sketch of Service Here

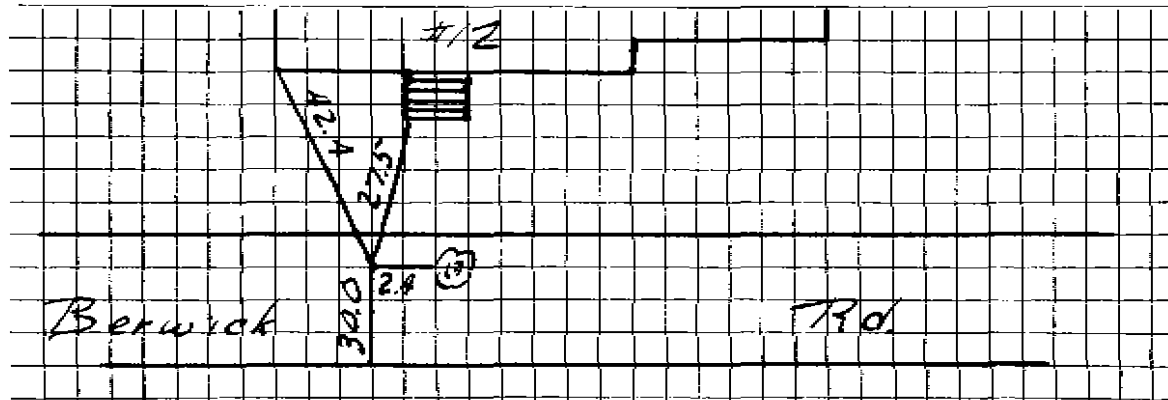

Connection made in ..... Street.

Work completed .....19

Remarks: