

Name ~~Henry F. Andrews~~ Guy E. Reed, Jr.

Service No. 15

Address 2 Berwick Road
Lexington, Mass.

Location 2 Berwick Road

Kind of Pipe

Size

Size of Main

~~Repair~~ - Renewal - ~~New Service~~

Com. 5-29-50

Location

Date	Material	Amount	Total	Date	Amount
Apr. 12, '50	Labor	31 97	31 97	<i>Feb 8 '50</i>	<i>70 00</i>
	10% Overhead		3 20		<i>25 27</i>
	90' - 3/4" Copper Tubing @.23	20 70	20 70		<i>No Charge</i>
	1 - 3/4"C x 1/2" I.W.H. S&W	3 29	3 29	Apr. 12, '50	Labor
	Trucking 1 hr. @.75		75		30 00
			<u>59 91</u>	32' - 3/4" Copper Tubing @.23	7 36
				1 - 3/4"C Adapter	1 50
				1 - 3/4"C x 3/4"C Curb-cock	3 85
				1 - Box & Rod	3 60
				1 - 1/2" Offset Tail Piece	38
				1 - 1/2" Straight Tail Piece	38
				Littlefield Shovel 4 hrs. @ 7.00	28 00
				Trucking 1 hr. @.75	75
	Labor			Patching 25 x 3	<u>25 00</u>
					100 82

TOWN OF LEXINGTON – BOARD OF PUBLIC WORKS

WATER DIVISION

The undersigned applies for a supply of water at No..... St. and hereby agrees to comply with the rules and regulations as now, or at any future time, established by the Board of Selectmen.

Am't of Estimate \$.....

Owner

Am't Paid \$.....


Address

Builder

.....

Sketch of Service Here

#2 BERNICK RD.

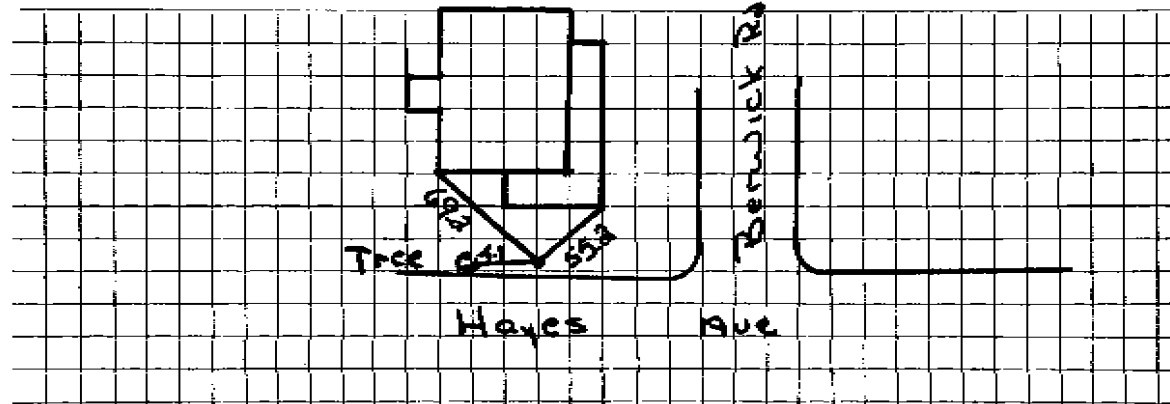

Connection made in Street.

Work completed19

Remarks: