

WATER SERVICE RECORD

Name Katherine E. Pumpelly

Service No. 6

Address 7 Berwick Road

Location

~~REPAIR - Renewal - REPAIR~~

Comm 8-4-59


Date	Material	Amount	Total	Date	Material	Amount
4-13-59	Labor	49.78		3-12-59	Deposit	125.00
	10% O.H.	4.98	54.76	5-4-59	Retard	14.99
55'	3/4" Copper tubing @.3666	20.16				110.01
1	3/4" C x 1/2 I.W.H. Stop & Waste	5.84			NON CHARGE	
1	hr. Trucking @.75	.75			Labor	10.91
5	hrs. Pippin Backhoe @4.50	22.50		12'	3/4" Copper tubing @.3666	4.40
2	hrs. Compressor @ 3.00	6.00		1	3/4" C Corp Cock	4.64
			110.01	1	3/4" C Curb Cock	6.03
				1	Box & Rod	5.00
				1	1/2 Straight tailpiece	.50
				1	1/2 Offset tailpiece	.50
				1	hr. Pippin Backhoe @4.50	4.50
				10	x 3 Patch	10.00
				11/18/70	17' 3/4 COPPER	46.48
					1 " CORP	
					1 " Curb	
					1 1" Repair Clamp ?	
					1 4" NIPPLE	

DATE _____

TOWN OF LEXINGTON — BOARD OF PUBLIC WORKS

WATER DIVISION

Sketch of Service Here

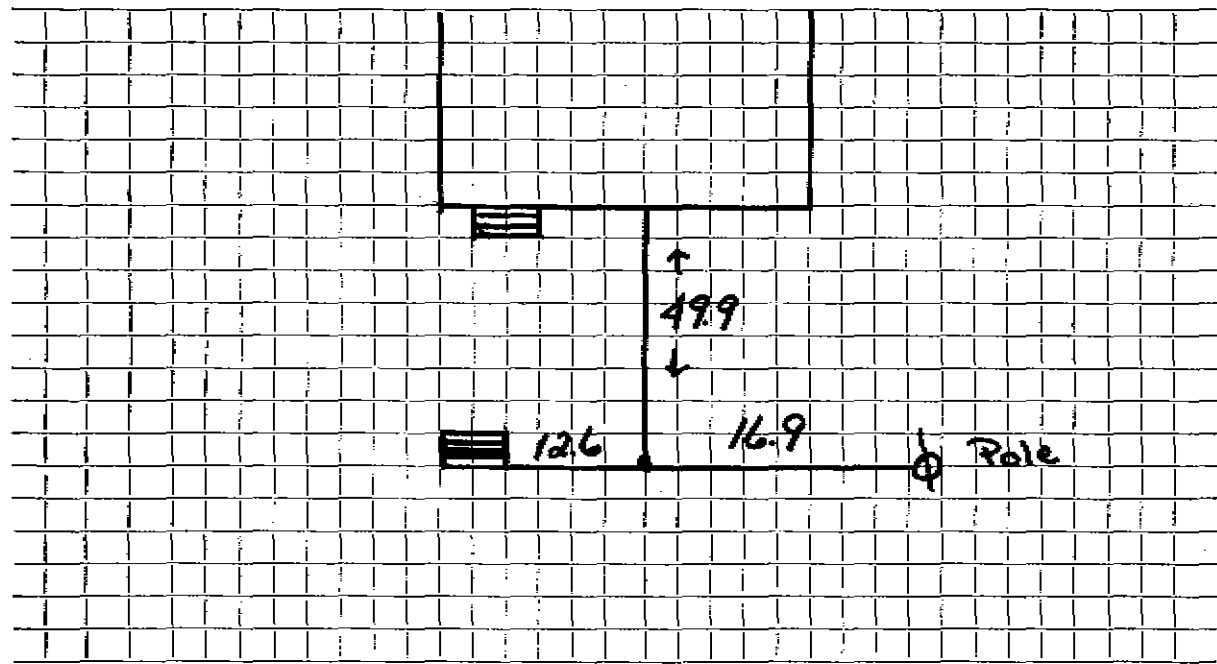

Connection made in Street. Work completed

Remarks:
.....
.....