

WATER SERVICE RECORD

Name Frank Conant

Service No. 25

Address 8 Berwick Road

# 1859  
# 2992

Location

Repair ~~XXXXX~~ Renewal ~~XXXXXXXXXX~~ New Service ~~XXXXXXXXXX~~ W. O. # 9728

AUG 14 1972


Date	Material	Amount	Total	Date	Amount
6/9/72	Labor	122 88		5-22-72	200 00
	10% O.H.	12 29	135 17	5-14-72	1 1/2
	44' 3/4" Copper pipe .79		34 76		198 84
	3/4" x 1/2" Stop & Waste		12 91		
	2 Hrs. Shovel 6/50		13 00	6/23/72	
	1 Hr. Trucking		3 00		
			198 84		
1926	45' 1" Pipe @ .20	9 00			
	1 1" Space Nipple	15			
	1 1" Ell	15			
	1 S and W	2 75	12 05		
	Total Labor		10 74		
	Overhead 15%		1 61		
			24 40		
May 13	10 hrs. @ .55 No charge			May 12 1926	20 40
14	17 1/3 hrs. @ .55	9 54		Oct 8 1926	20 00
	2 hrs. @ .60	1 20	10 74	deposited to # 97	1 40

DATE \_\_\_\_\_

TOWN OF LEXINGTON — BOARD OF PUBLIC WORKS

**WATER DIVISION**

Sketch of Service Here

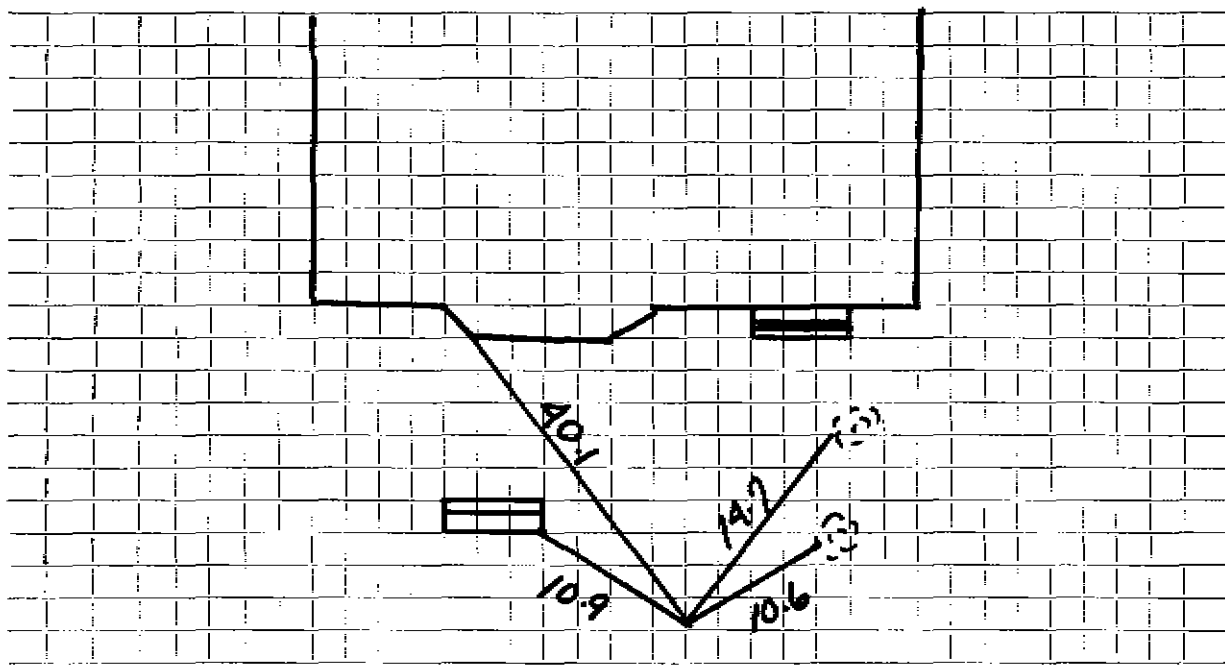

Connection made in ..... Street. Work completed .....

Remarks: .....  
.....  
.....