WATER SERVICE RECORD

Service No.

Name

Kerri Realty Trust


Address 10 Bicentennial Drive Location Repair—Renewal—New Service Eagle #3100 Material Total Date Amount Date Amount 11/30/78 1" Copper 42'

| DAT | E | |
|-----|---|------|
| | | |

TOWN OF LEXINGTON - BOARD OF PUBLIC WORKS

WATER DIVISION

Sketch of Service Here

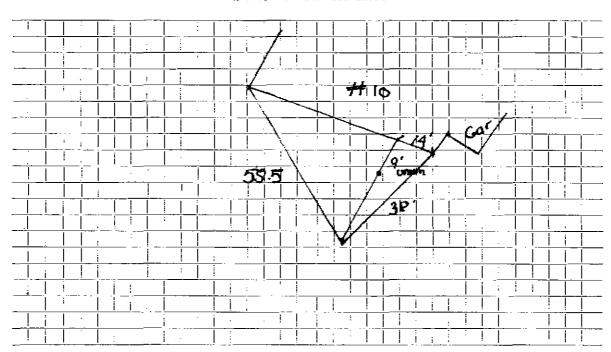

| Connection made in Street. | Work completed |
|----------------------------|---|
| Remarks: | *************************************** |
| | |