WATER SERVICE RECORD


Service No. Name Kerrie Realty, Tr. Address ll Bicentennial Drive Location Repair Renewalx New Service Dave Eagle #3010 Material Amount Total Date Amount Date 7/27/77 58' 1" copper

DATE	<u> </u>
------	----------

TOWN OF LEXINGTON - BOARD OF PUBLIC WORKS

WATER DIVISION

Sketch of Service Here

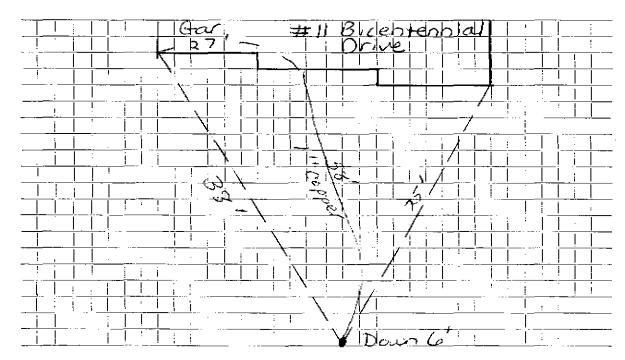

Connection made in	Street.	Work completed

Remarks: