


DATE _____

TOWN OF LEXINGTON — BOARD OF PUBLIC WORKS

WATER DIVISION

Sketch of Service Here

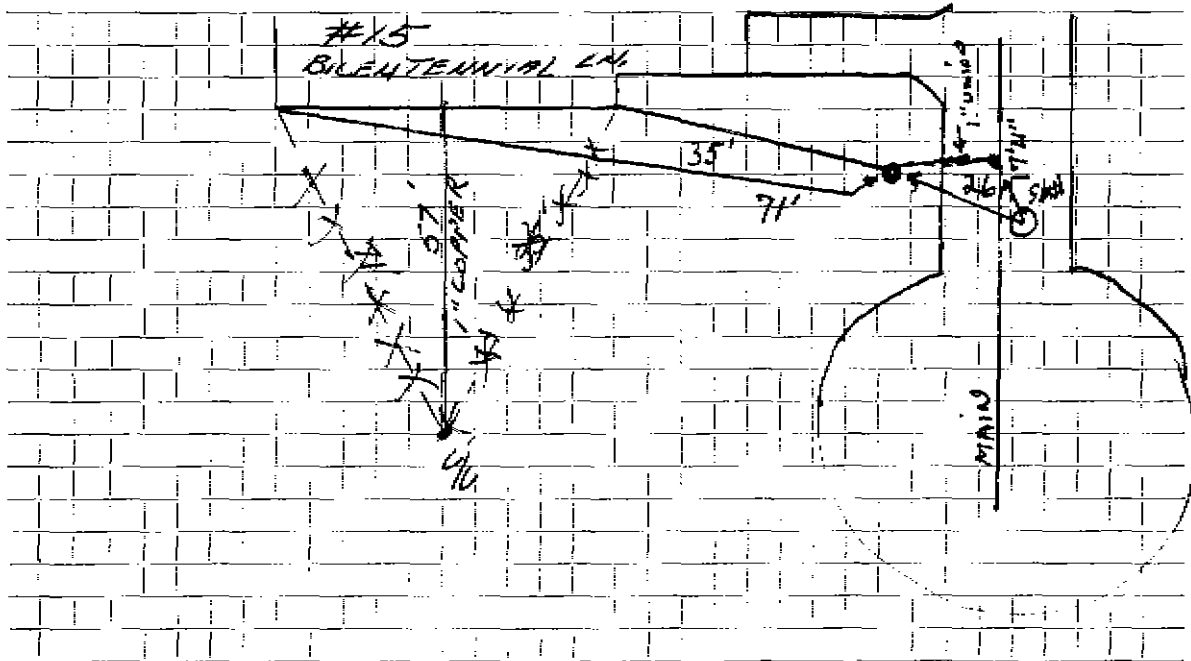

Connection made in BICENTENNIAL LN. Street. Work completed

Remarks: 1 1/2' - 1" Copper Corp. to Union