


DATE _____

TOWN OF LEXINGTON — BOARD OF PUBLIC WORKS
WATER DIVISION

Sketch of Service Here

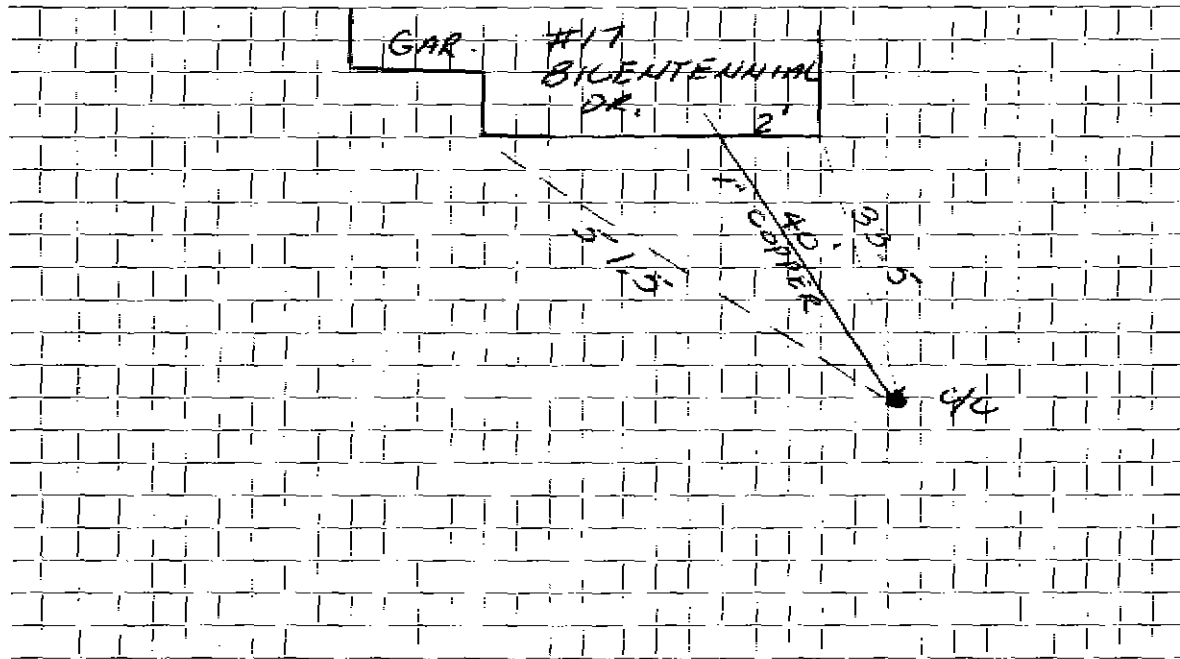

Connection made in BICENTENNIAL DR. ~~Street~~ Work completed

Remarks: WATER & SEWER IN SAME TRENCH

.....
.....