


TOWN OF LEXINGTON — BOARD OF PUBLIC WORKS

WATER DIVISION

DATE _____

Sketch of Service Here

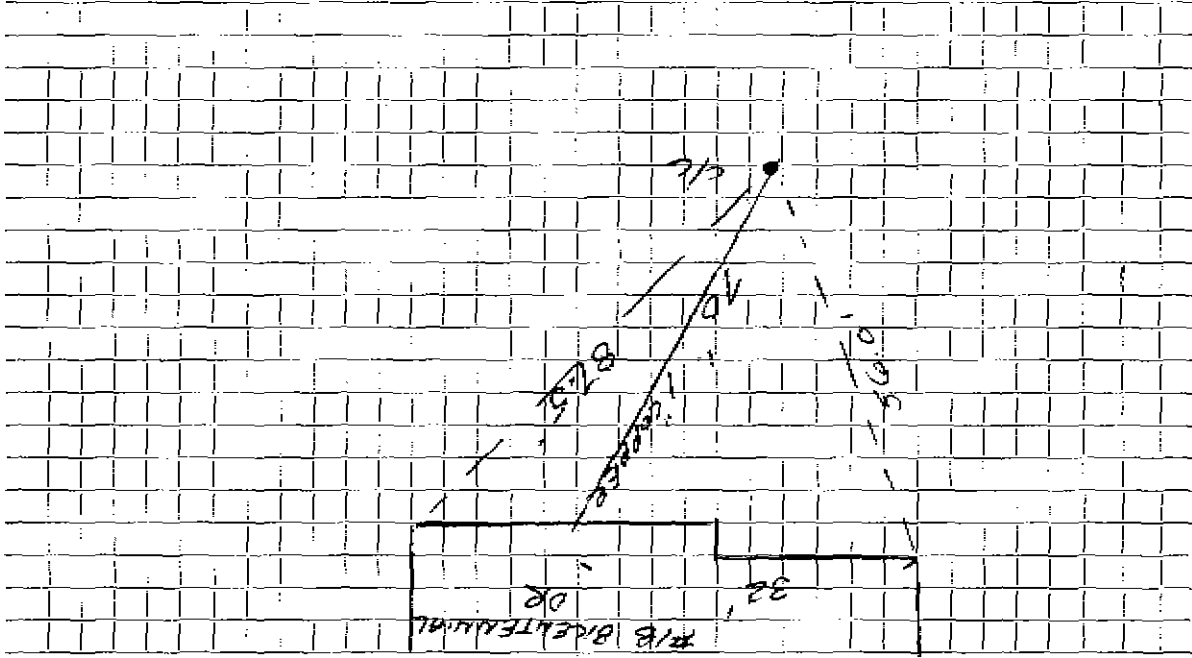

Work completed

Connection made in ~~Street~~ BIRCHMOUNT DR.

Remarks: