

### WATER SERVICE RECORD

Name

Service No.

Address

3 Bicentennial Drive

Location

Repair - ~~Renewal~~ - New Service

1/29/77

**Date                                  Material                                  Amount                                  Total                                  Date                                  Amount**


7/29/77   29' 1" Copper

DATE \_\_\_\_\_

TOWN OF LEXINGTON -- BOARD OF PUBLIC WORKS

**WATER DIVISION**

Sketch of Service Here

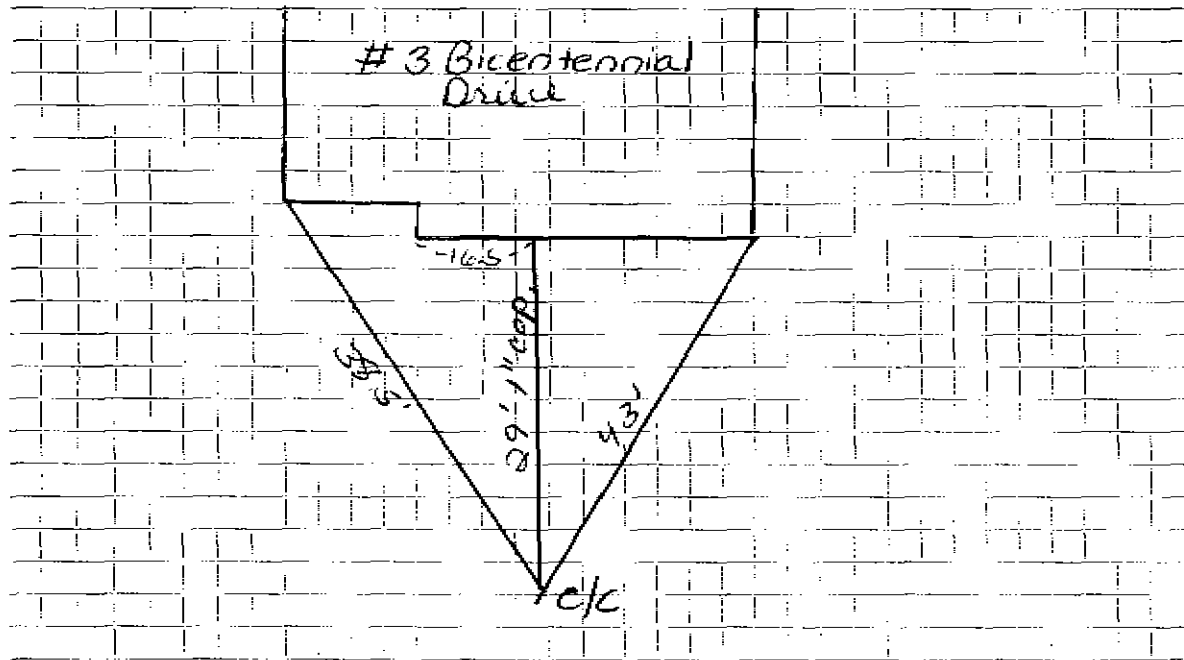

Connection made in ..... Street. Work completed .....

Remarks: .....

.....

.....