




TOWN OF LEXINGTON — BOARD OF PUBLIC WORKS

WATER DIVISION

DATE \_\_\_\_\_

Sketch of Service Here

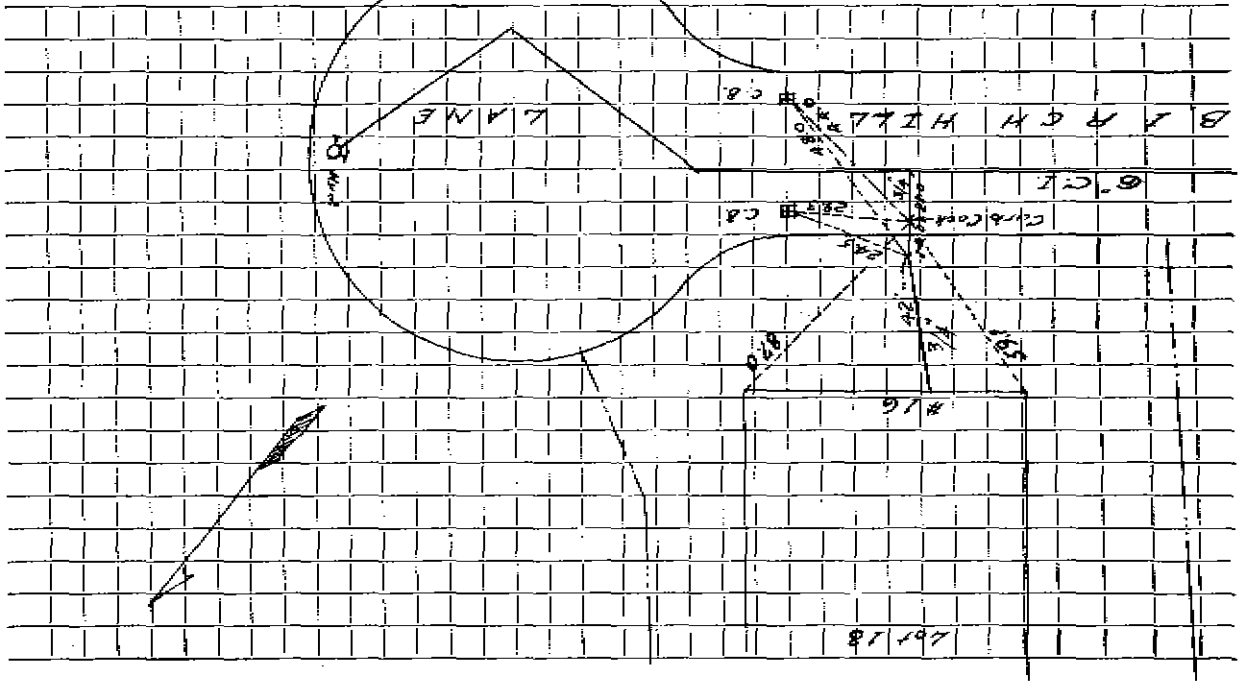

Connection made in \_\_\_\_\_ Street. \_\_\_\_\_ Work completed \_\_\_\_\_

Remarks: \_\_\_\_\_