


TOWN OF LEXINGTON — BOARD OF PUBLIC WORKS
WATER DIVISION



Connection made in _____ Street. Work completed _____

Remarks: _____

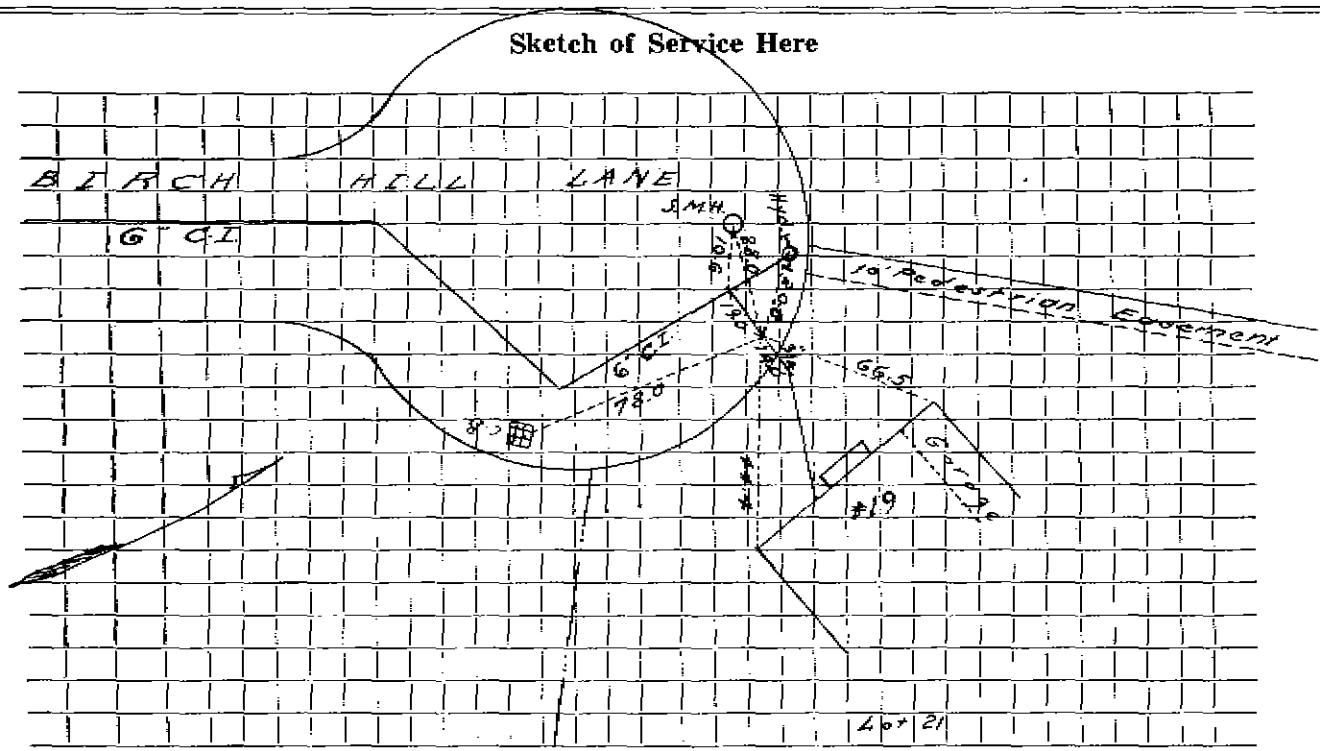