




DATE \_\_\_\_\_

TOWN OF LEXINGTON — BOARD OF PUBLIC WORKS

WATER DIVISION

Sketch of Service Here

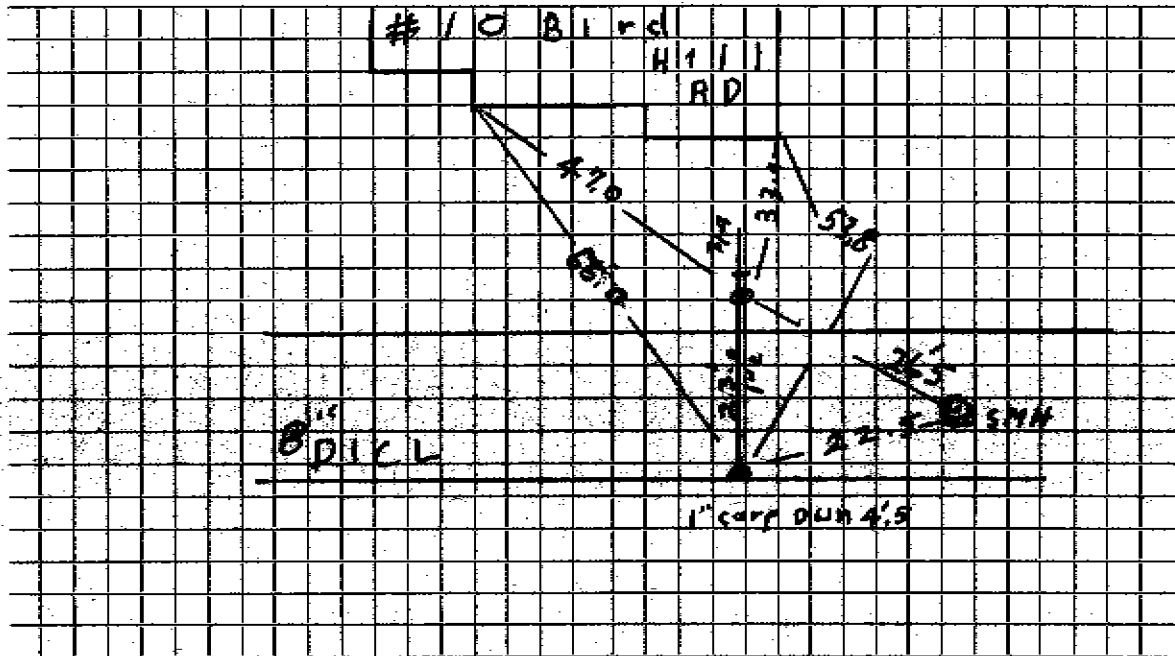

Connection made in B. Hill Street. Work completed 7/27/09 PAO

Remarks: corp 4'S DN 4'S