


DATE

TOWN OF LEXINGTON — BOARD OF PUBLIC WORKS

WATER DIVISION

Sketch of Service Here

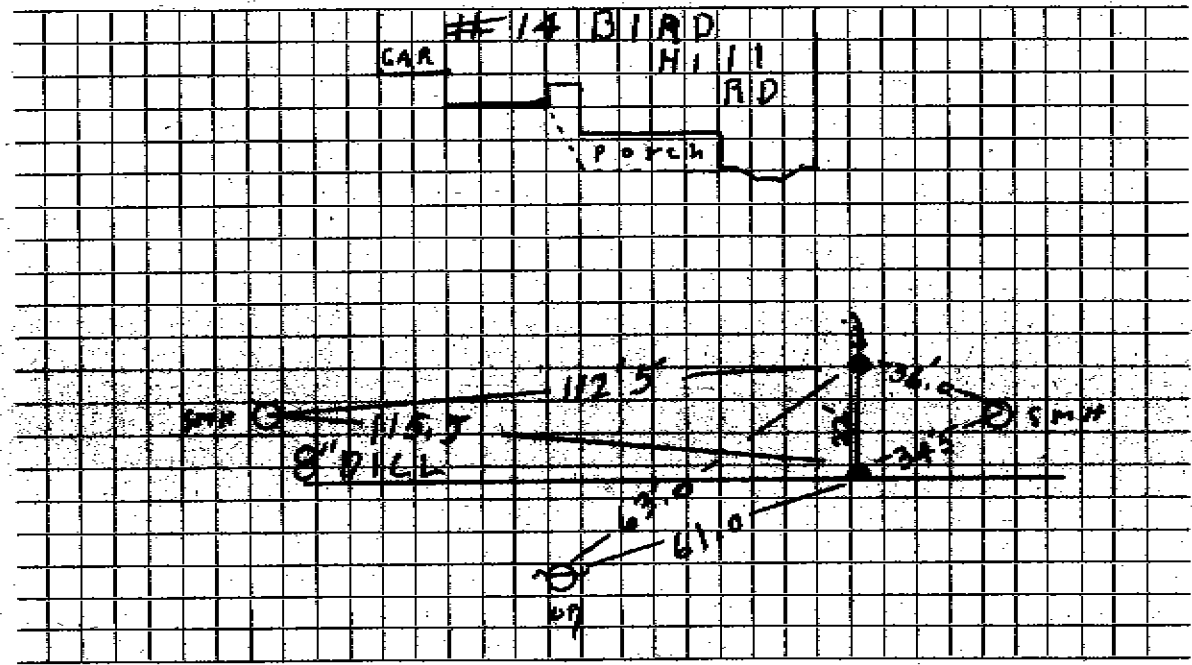

Connection made in Street.

Work completed 7/20/09 P.A.O

Remarks: Corp. Duens 4'3" curb-3'6"