


DATE _____

TOWN OF LEXINGTON — BOARD OF PUBLIC WORKS

WATER DIVISION

Sketch of Service Here

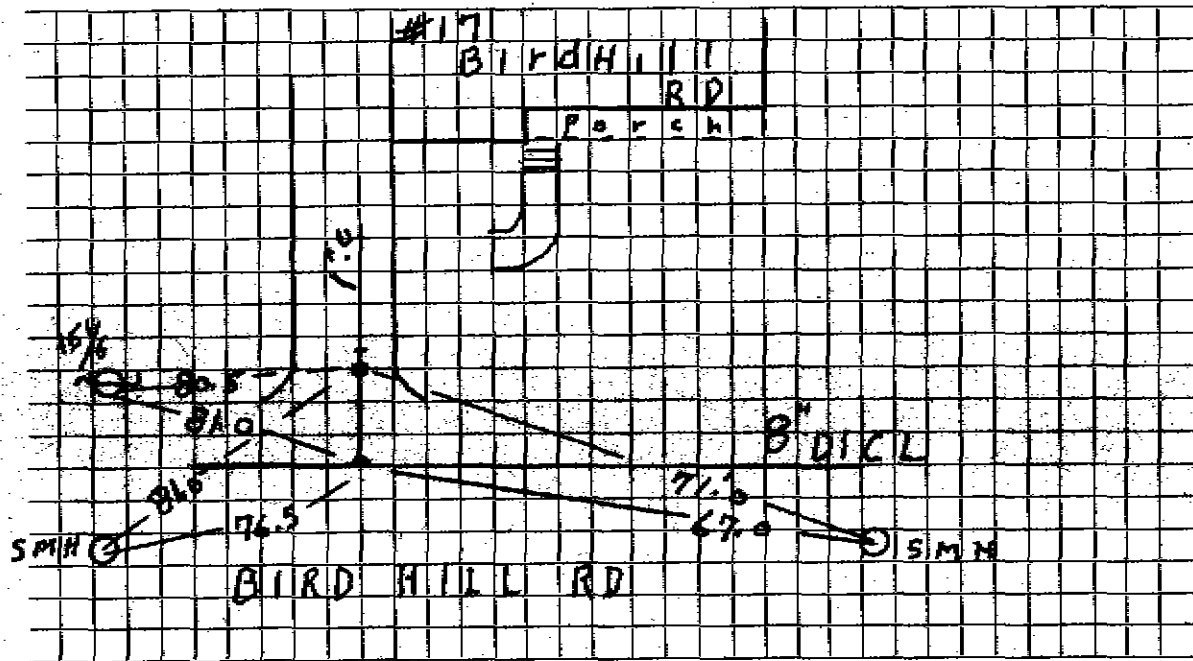

Connection made in Street. Work completed 7/28/09 PAO

Remarks: Curb DWN A.T. Corp. ?