


DATE _____

TOWN OF LEXINGTON — BOARD OF PUBLIC WORKS

WATER DIVISION

Sketch of Service Here

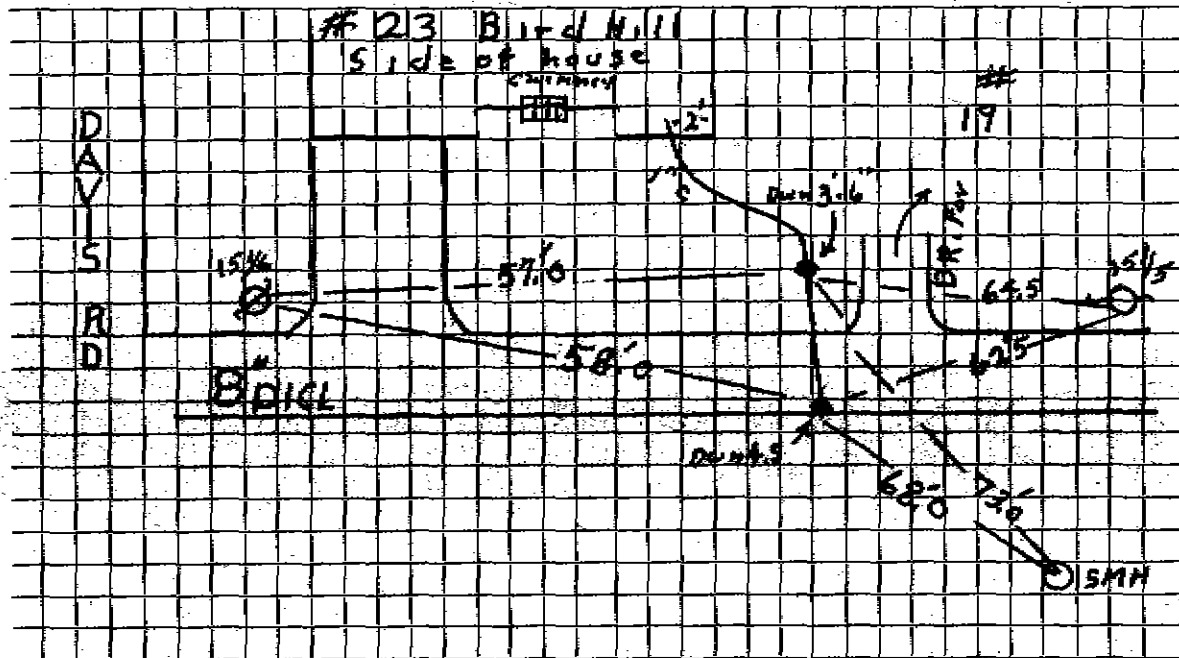

Connection made in Bird Hill Street. Work completed 7/30/09 PAZO Cor.P.

Remarks:

.....

.....