


DATE _____

TOWN OF LEXINGTON — BOARD OF PUBLIC WORKS

WATER DIVISION

Sketch of Service Here

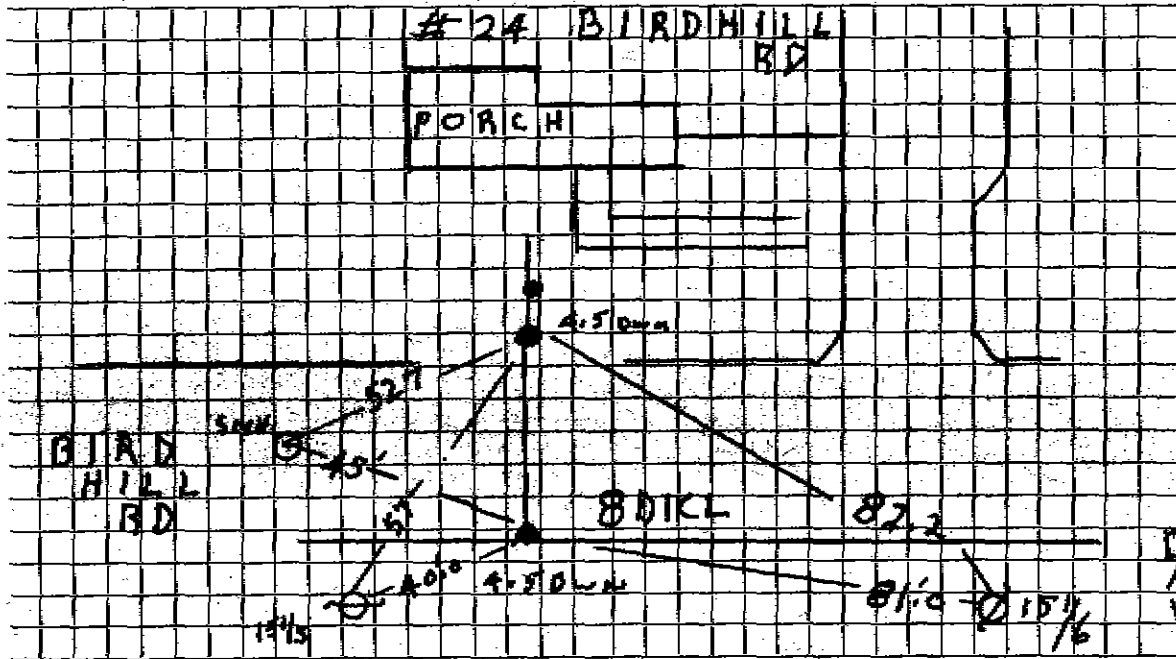

Connection made in Street. Work completed 7/28/09 P.P.O.

Remarks: Service is run under floor to back room in bed of sand - 2002

... Crew did NOT dig to exist. Luck & box left in place - 2009