




DATE

TOWN OF LEXINGTON -- BOARD OF PUBLIC WORKS

WATER DIVISION

Sketch of Service Here

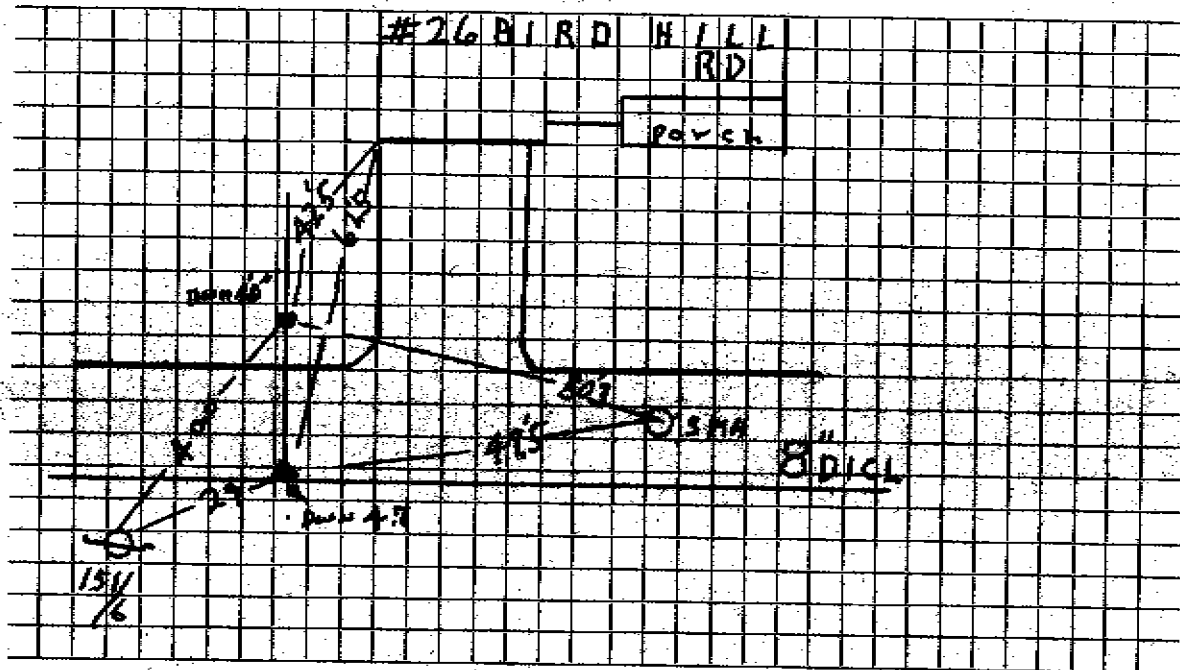

Connection made in..... Street.

Work completed 7/30/09 P.A.O Corp.....

Remarks:.....  
.....  
.....