

WATER SERVICE RECORD

Name Moore Construction Co.

Service No. 229

Address 4 ~~Subsidiary~~ Bird Hill Rd name is: Edward Lyons

Location Lexington

L 100

REPAIR WORK—New Service COM. 12-8-52


Date	Material	Amount	Total	Date	Amount
11/13/52	Labor	3 26		9-29-52 Deposited	100
	10% overhead	33	3 59	12-8-52 Refunded	(25)
	96' 3/4" copper tubing@.34	34	32 64	NON CHARGE	104
	1 -3/4"Cx 1/2 I.W.F.stop & waste		4 00	11/13/52 Labor	13
	1 -3/4"C x 3/4" C.union		1 72	18' - 3/4" copper tubing@.34	6
	2 hrs. Littlefield shovel		14 00	1 -3/4"C. corp-cock	4
	1 hr. trucking		75	1 -3/4"C x 3/4"C. curb-cock	4
	patching 8 x 3		8 00	1 box and rod	3
			64 70	1 -1/2 offset tail pc.	
	TRENCH DUG BY OWNER:			1 -1/2 straight tail pc.	
				3 hrs. Littlefield shovel	21
				2 hrs. trucking	1
					58

DATE _____

TOWN OF LEXINGTON — BOARD OF PUBLIC WORKS

WATER DIVISION

Sketch of Service Here

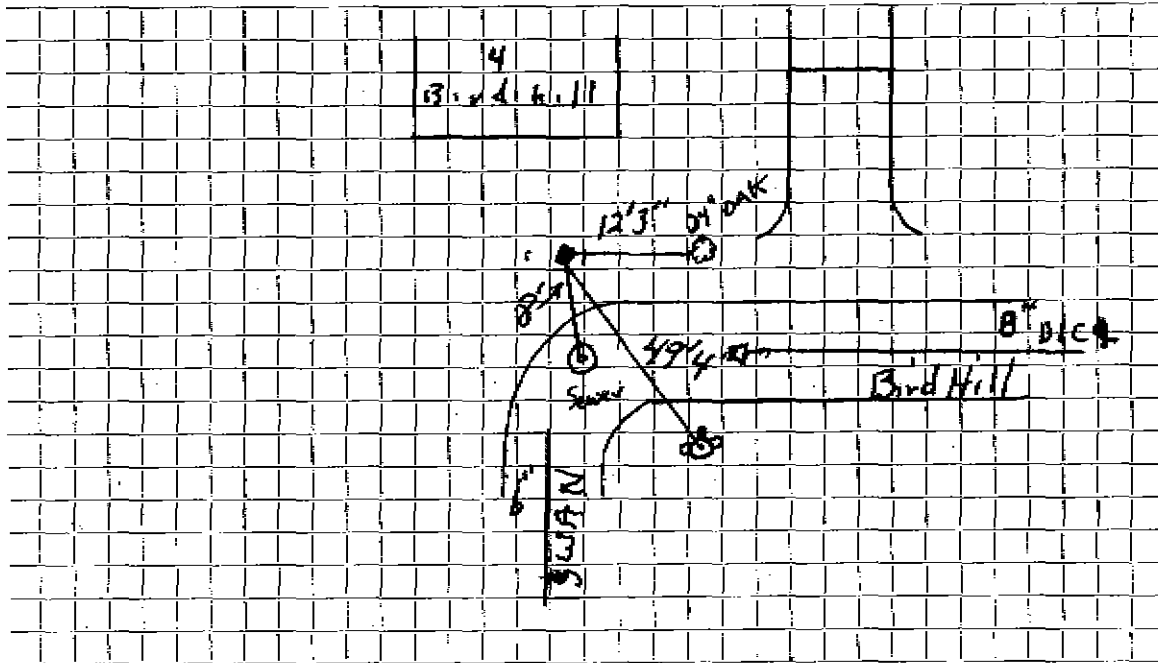

Connection made in OLD SEC-6" W Street. Work completed

Remarks: