

WATER SERVICE RECORD

Name VELDKAMP

Service No.

Address 7 Bird Hill RD

Location

Lot 27

Repair—Renewal—New Service


Date		Material	Amount		Total		Date	P.A.O	Amount	
12/1/88	Repair	3/4 Copper					7/27/09	16'	1" Copper	
		3/4 Comp. Unions							1" Comp	
		3/4 1/2 S.W.							1" curb box	
									1 1/2 Red	
									bufflo box	

DATE \_\_\_\_\_

TOWN OF LEXINGTON — BOARD OF PUBLIC WORKS

WATER DIVISION

Sketch of Service Here

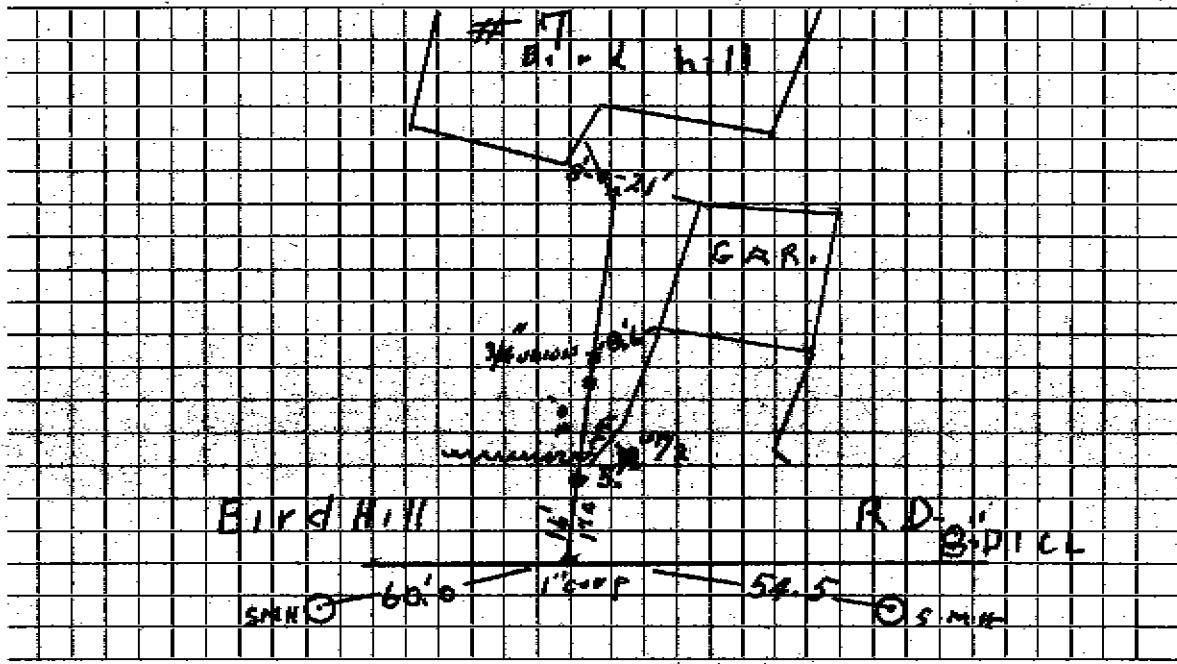

Connection made in ..... Street. Work completed 7/27/09 P.A.O. Corp.....

Remarks: Corp. DWN 4' 3" / Corp. DWN 4' 5" - 2009

Service broken 2 times by cont. 12-1-1988 - (Union's by Garage 2' deep. Owner told to lower.)  
Water Service, chose NOT to do it.