


DATE _____

TOWN OF LEXINGTON — BOARD OF PUBLIC WORKS

WATER DIVISION

Sketch of Service Here

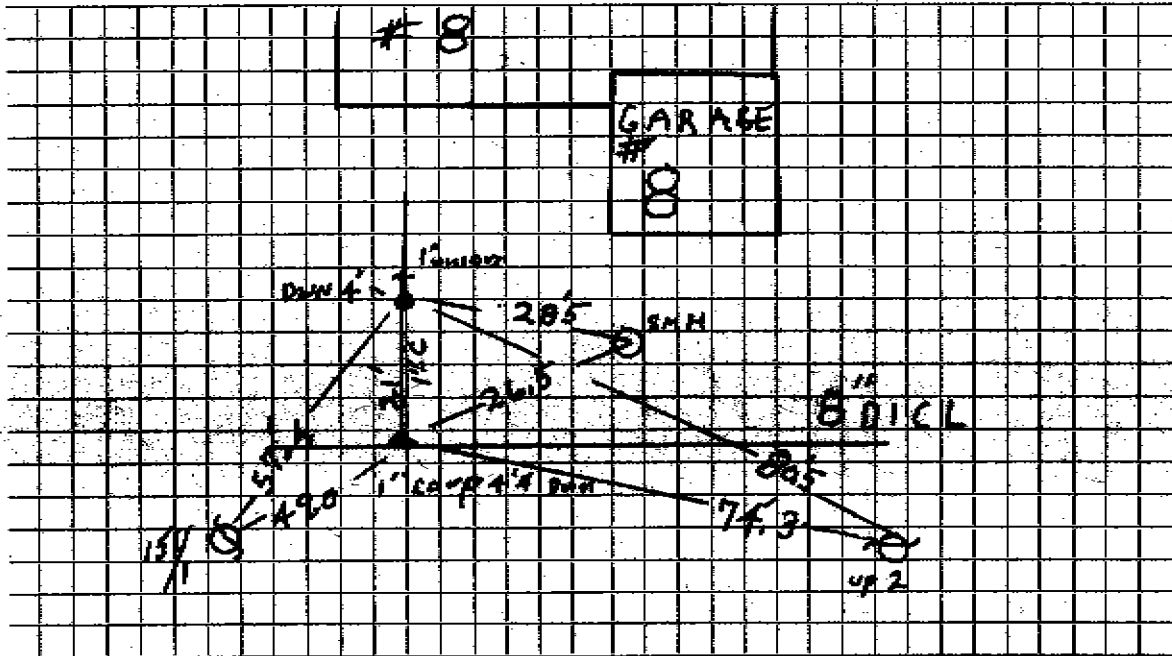

Connection made in Wind Hill Street.

Work completed 7/28/09 P.A.O. Corp.

Remarks:

.....

.....